

1		2		3		4		5		6		7		8			
A	1. THE CUSTOMER IS RESPONSIBLE FOR UPS (UNINTERRUPTIBLE POWER SUPPLY) FOR NETWORK EQUIPMENT. GE VERNOVA SUGGESTS THAT THE CUSTOMER USE SEPARATE CIRCUITS TO POWER THE REDUNDANT EQUIPMENT (I.E. ETHERNET SWITCHES). 2. LENGTHS OF CAT-6 UTP AND FIBER OPTIC CABLE ARE TO BE DETERMINED AT INSTALLATION . 3. EACH HUMAN MACHINE INTERFACE (HMI, EWS, APPLICATION GATEWAY, SYSTEM CONFIGURATION SERVER, CONTROL SERVER, THIN CLIENT) AND ON-SITE MONITORING PC (OSM) COMES WITH A 50 FT PRE-FABRICATED CAT-6 UTP (1000 BASE-T) CABLE PER NETWORK INTERFACE CARD PORT. THE OPERATOR INTERFACE (OI) USER INTERFACE DOES NOT INCLUDE CONNECTING NETWORK CABLES. GE VERNOVA ALSO PROVIDES ONE ADDITIONAL 1000 FT SPOOL OF CAT-6 UTP (1000 BASE-T) AND FIVE BOXES OF 20 RJ-45 CONNECTORS, WHICH SHOULD BE USED TO SATISFY THE AS-INSTALLED CABLE LENGTH NEEDS.NETWORK TIME SERVER (NTP) (IF SUPPLIED BY GE VERNOVA) COMES WITH 150 FT LENGTH OF COAXIAL CABEL FOR CONNECTION TO GPS ANTENNA (IF SUPPLIED BY GE VERNOVA). HOWEVER, IF ADDITIONAL ANY CABLE, CONNECTORS OR REPEATORS ARE REQUIRED, CUSTOMER IS RESPONSIBLE FOR THE ADDITIONAL SUPPLY . 4. NETWORK HARDWARE THAT IS SUPPLIED BY GE VERNOVA IS SHIPPED LOOSE .THIS HARDWARE IS LOCATED AND INSTALLED BY THE CUSTOMER. 5. THE ON-SITE MONITOR (OSM), WHICH CONSISTS OF HARDWARE AND SOFTWARE, IS PROVIDED FOR THE LENGTH OF THE STANDARD WARRANTY PERIOD OR THE LENGTH OF ANY EXTENDED CONTRACT SERVICE AGREEMENT (CSA). THE OSM IS USED TO MONITOR SELECTED UNIT AND FLEET DATA. THE MONITORING SERVICE DOES NOT REQUIRE OPERATOR INTERACTION FROM THE SITE. GE VERNOVA REQUIRES THAT THE CUSTOMER PROVIDE A HIGH SPEED INTERNET CONNECTION (HSC) IN ORDER TO ENSURE CONTINUED MONITORING.GEK-120850 MAY BE REFERRED FOR REQUIREMENTS OF THE HSC. THE HARDWARE INSTALLED FOR REMOTE MONITORING PURPOSES REMAINS THE PROPERTY OF CUSTOMER. THE SOFTWARE REMAINS THE PROPERTY OF GE VERNOVA AND WILL BE DISABLED AT THE COMPLETION OF THE MONITORING PERIOD AT THE DISCRETION OF THE GAS POWER BUSINESS. 6. ALL OPERATOR INTERFACES INCLUDING THE HMI AND OSM ARE TO BE LOADED WITH HARDWARE AND SOFTWARE AUTHORIZED BY GE VERNOVA POWER ONLY. INSTALLATION OF ANY SOFTWARE OR HARDWARE NOT AUTHORIZED BY GE VERNOVA POWER WILL VOID GE VERNOVA WARRANTY AGREEMENTS AND ALSO MAY CAUSE NETWORK INTERFACE PROBLEMS. 7. THE CUSTOMER AGREES BY USE OF THE GE VERNOVA CONTROL SYSTEM THAT THE TOOLS, SOFTWARE, COPYRIGHTED OPERATOR STATION SCREENS, DRAWINGS, SCHEMATICS, LOGIC, AND OTHER INTELLECTUAL PROPERTY PROVIDED WITH GE VERNOVA’S CONTROL SYSTEMS, OPERATOR STATIONS, AND RELATED COMPONENTS ARE PROPRIETARY INFORMATION OWNED BY GE VERNOVA OR OTHER PARTIES, PROTECTED BY LAW, AND LICENSED TO THE CUSTOMER FOR THEIR USE ON THEIR SPECIFIC PROJECT APPLICATION ONLY. THE CUSTOMER IS EXPRESSLY FORBIDDEN FROM REVERSE ENGINEERING, DECOMPILING, OR OTHERWISE DERIVING THE SOURCE OF THE PROPRIETARY INFORMATION THROUGH ANY MEANS OR FROM REPRODUCING, DISTRIBUTING, DISCLOSING, OR ALLOWING ACCESS TO ANY GE VERNOVA PROPRIETARY INFORMATION, IN ANY FORM, TO ANY THIRD PARTY, WITHOUT GE VERNOVA'S PRIOR WRITTEN PERMISSION. SUCH AUTHORIZATION WILL LIKELY REQUIRE AN AGREEMENT BETWEEN GE VERNOVA AND THE THIRD PARTY. 8. ALL EXTERNAL DATALINK INTERFACES COMMUNICATING TO GE VERNOVA CONTROLS NETWORK THROUGH NETWORKST 4.0 EXTERNAL SWITCHES USING SINGLE MODE FIBER NEED TO COMMUNICATE USING 1 GBPS SPEED ONLY. IF ANY DATALINK INTERFACE IS NOT ABLE TO COMMUNICATE USING 1 GBPS SPEED THEN PARTNER OR CUSTOMER NEED TO PROVIDE FIBER TO COPPER CONVERTOR AT NETWORKST 4.0 (EXTERNAL SWITCHES) END AND NEED TO SHARE THIS INFORMATION IN EARLY STAGE OF TH E PROJECT SO GE VERNOVA CAN ORDER THE CORRECT HARDWARE NEEDED.							Revision History								A	
								REV	DESCRIPTION					DATE	APPROVALS		B
B								E	- External switch & UTM port tables sheet updated as per markup. - Central control room(osw4clt) monitor size has been updated to 85". - Switch port tables(SW4-1,SW4-2) updated as per markup. - Updated the location of Network cabinet4-BSC1CLT in server room to cybersecurity room - In Sheet-25, HRSGLMCLT ,PMSSVR,uPMSSVR is removed in the portable. - In sheet-26 BSC1CLT location is updated from Server room to Cyber Security room.					2025-11-14	Created By: SAI NIKHIL REDDY Y.R Approved By: Janaki,Paramkusam		
C								THIS DOCUMENT SHALL BE REVISED IN ITS ENTIRETY. ALL SHEETS OF THIS DOCUMENT ARE THE SAME REVISION LEVEL AS INDICATED IN THE REVISION BLOCK.								D	
D								ASSY, REMOTE CONTROL SYS DESIGN MEMO: 1511771 GT TURBINE SERIAL NUMBER: 899061 ST TURBINE SERIAL NUMBER: 370T080 MODEL LIST: 4108 CUSTOMER: OSTROLEKA									E
E																F	
F																	
1		2		3		4		5		6		7		8			


LEGEND		
SYMBOL	DESCRIPTION	
	DEFINES CUSTOMER'S SCOPE	
	DEFINES GAS TURBINE ORDER SCOPE	
	DEFINES STEAM TURBINE ORDER SCOPE	
	DEFINES GE-DCS ORDER SCOPE	
	DEFINES PEECC	
	DEFINES LCI & EXCITER COMPARTMENT(LEC)	
	DEFINES EXCITER COMPARTMENT(EC)	
	DEFINES UNIT MOTOR CONTROL CENTER(MCC)	

NLR
Copyright © GE Vernova and/or its affiliates 2021-2025
All rights reserved. The information herein is proprietary information of GE Vernova and/or its affiliates. Thus, it is being provided with the explicit expectation of restricted use. All persons or legal entities receiving this information shall be deemed by the act of its receipt to have contractually agreed to make no duplications, reproductions of any nature by any means, modifications, disclosures, or use any portion of this material; except as is expressly authorized in writing by GE Vernova and/or its affiliates.

Similar To:		Created By:		MLI:	
NONE		PATNAIK, MANISH		4108	
First Made For: 1511771		Approved By:		IEC61355 NO:	
MPL-		GUDA, RAGHU		-	
 GE VERNOVA		Document Type:		Sheet Size:	
		TECHNICAL DOCUMENT		B	
		Document Title:			
		ASSY, REMOTE CONTROL SYS			
Creation Date:		Drawing Number:		Revision:	Sheet:
2021-10-28		302T0147		E	1 of 27

LEGEND	
SYMBOL	DESCRIPTION
	DEFINES CUSTOMER'S SCOPE
	DEFINES GAS TURBINE ORDER SCOPE
	DEFINES STEAM TURBINE ORDER SCOPE
	DEFINES GE-DCS ORDER SCOPE
	DEFINES PEECC
	DEFINES LCI & EXCITER COMPARTMENT(LEC)
	DEFINES EXCITER COMPARTMENT(EC)
	DEFINES UNIT MOTOR CONTROL CENTER(MCC)

NLR
Copyright © GE Vernova and/or its affiliates 2021-2025
All rights reserved. The information herein is proprietary information of GE Vernova and/or its affiliates. Thus, it is being provided with the explicit expectation of restricted use. All persons or legal entities receiving this information shall be deemed by the act of its receipt to have contractually agreed to make no duplications, reproductions of any nature by any means, modifications, disclosures, or use any portion of this material; except as is expressly authorized in writing by GE Vernova and/or its affiliates.

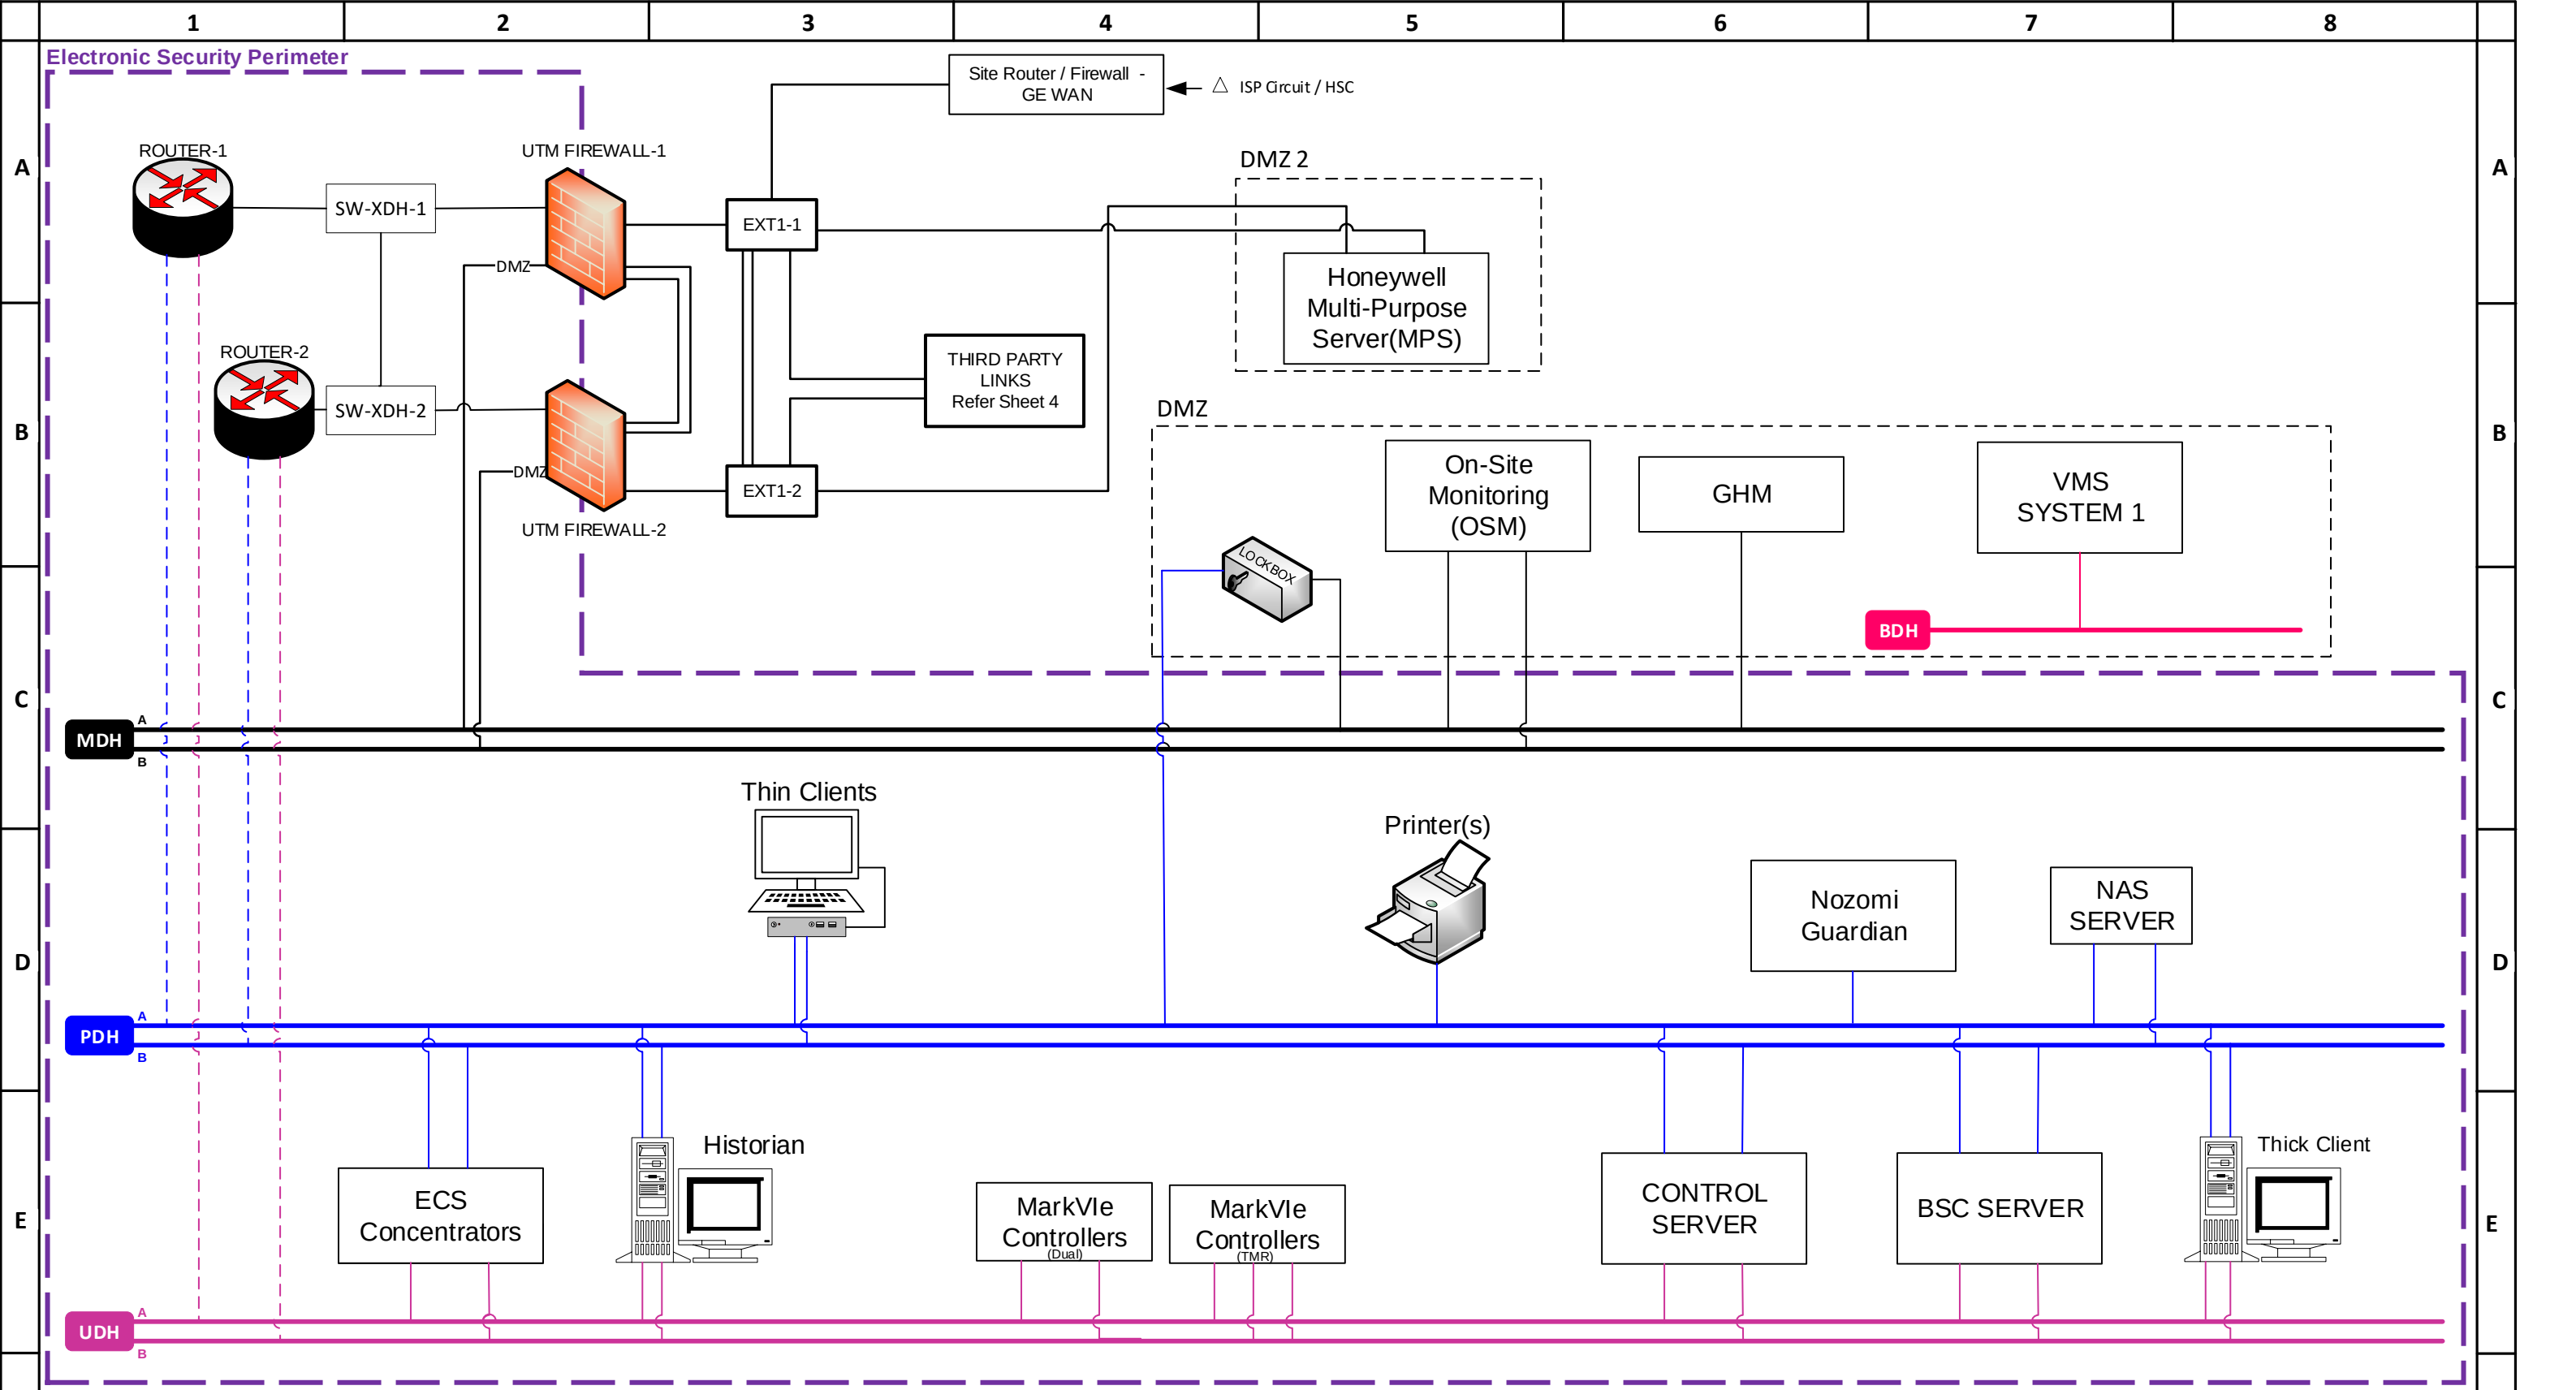


NETWORKST 4.0 – SINGLE LINE OVERVIEW	NOTE: SPEED ON DATA HIGHWAYS (UDH/PDH/MDH) IS 1 GBPS	GE VERNOVA	Document Type:		Sheet Size:	
			TECHNICAL DOCUMENT		B	
			Document Title:			
			ASSY, REMOTE CONTROL SYS			
Creation Date:		Drawing Number:		Revision:	Sheet:	
2021-10-28		302T0147		E	3 of 27	

1		2		3		4		5		6		7		8																																																																								
A	Switch: EXT1-1 (11CSA02GH020) ID#: 38 Location: SERVER ROOM - NETWORK CABINET 2 Part No: 117T6409P54Y1AAA E Type: SMF VLAN STACKED EXTERNAL SW WITH 24SFP Power Source: UPS1 <table><thead><tr><th>VLAN</th><th>MEDIA</th><th>ID#</th><th>PORT</th><th>DEVICE</th><th>DEVICE DESCRIPTION</th><th>IP ADDRESS</th></tr></thead><tbody><tr><td>VLAN59</td><td>CAT6</td><td>5</td><td>1</td><td>UTM1-Port 16</td><td>UTM1-Port 16</td><td>172.16.172.1</td></tr><tr><td>VLAN50</td><td>CAT6</td><td>5</td><td>2</td><td>SITE ROUTER/FW</td><td>SITE ROUTER / FIREWALL Orlen Jump Host</td><td>TBD</td></tr><tr><td>VLAN50</td><td>CAT6</td><td>5</td><td>3</td><td>UTM-1 PORT 3</td><td>UTM-1 PORT 3</td><td>192.168.254.253</td></tr><tr><td>VLAN70</td><td>CAT6</td><td>5</td><td>4</td><td>UTM-1 PORT 15</td><td>UTM-1 PORT 15</td><td>172.16.145.129</td></tr><tr><td>VLAN52</td><td>CAT6</td><td>5</td><td>5</td><td>UTM-1 PORT 8</td><td>UTM-1 PORT 8</td><td>172.16.171.1</td></tr><tr><td>VLAN53</td><td>CAT6</td><td>5</td><td>6</td><td>UTM-1 PORT 14</td><td>UTM-1 PORT 14</td><td>10.151.198.101</td></tr><tr><td>VLAN58</td><td>CAT6</td><td>5</td><td>7</td><td>UTM-1 PORT 13</td><td>UTM-1 PORT 13</td><td>172.30.128.65</td></tr><tr><td>VLAN51</td><td>CAT6</td><td>5</td><td>8</td><td>UTM-1 PORT 9</td><td>UTM-1 PORT 9</td><td>172.16.160.1</td></tr><tr><td>VLAN55</td><td>CAT6</td><td>5</td><td>9</td><td>UTM-1 PORT 10</td><td>UTM-1 PORT 10</td><td>10.151.103.1</td></tr></tbody></table>															VLAN	MEDIA	ID#	PORT	DEVICE	DEVICE DESCRIPTION	IP ADDRESS	VLAN59	CAT6	5	1	UTM1-Port 16	UTM1-Port 16	172.16.172.1	VLAN50	CAT6	5	2	SITE ROUTER/FW	SITE ROUTER / FIREWALL Orlen Jump Host	TBD	VLAN50	CAT6	5	3	UTM-1 PORT 3	UTM-1 PORT 3	192.168.254.253	VLAN70	CAT6	5	4	UTM-1 PORT 15	UTM-1 PORT 15	172.16.145.129	VLAN52	CAT6	5	5	UTM-1 PORT 8	UTM-1 PORT 8	172.16.171.1	VLAN53	CAT6	5	6	UTM-1 PORT 14	UTM-1 PORT 14	10.151.198.101	VLAN58	CAT6	5	7	UTM-1 PORT 13	UTM-1 PORT 13	172.30.128.65	VLAN51	CAT6	5	8	UTM-1 PORT 9	UTM-1 PORT 9	172.16.160.1	VLAN55	CAT6	5	9	UTM-1 PORT 10	UTM-1 PORT 10	10.151.103.1	A
	VLAN	MEDIA	ID#	PORT	DEVICE	DEVICE DESCRIPTION	IP ADDRESS																																																																															
	VLAN59	CAT6	5	1	UTM1-Port 16	UTM1-Port 16	172.16.172.1																																																																															
	VLAN50	CAT6	5	2	SITE ROUTER/FW	SITE ROUTER / FIREWALL Orlen Jump Host	TBD																																																																															
	VLAN50	CAT6	5	3	UTM-1 PORT 3	UTM-1 PORT 3	192.168.254.253																																																																															
	VLAN70	CAT6	5	4	UTM-1 PORT 15	UTM-1 PORT 15	172.16.145.129																																																																															
	VLAN52	CAT6	5	5	UTM-1 PORT 8	UTM-1 PORT 8	172.16.171.1																																																																															
	VLAN53	CAT6	5	6	UTM-1 PORT 14	UTM-1 PORT 14	10.151.198.101																																																																															
	VLAN58	CAT6	5	7	UTM-1 PORT 13	UTM-1 PORT 13	172.30.128.65																																																																															
	VLAN51	CAT6	5	8	UTM-1 PORT 9	UTM-1 PORT 9	172.16.160.1																																																																															
VLAN55	CAT6	5	9	UTM-1 PORT 10	UTM-1 PORT 10	10.151.103.1																																																																																
B	VLAN56	CAT6	5	10	UTM-1 PORT 11	UTM-1 PORT 11	172.16.180.1																																																																															
	VLAN57	CAT6	5	11	UTM-1 PORT 12	UTM-1 PORT 12	172.16.190.1																																																																															
	VLAN58	SMF	5	12	DATA LINK	TT SOWE\LFC (MODBUS)	See table 1P below																																																																															
	VLAN54	SMF	5	13	DATA LINK	DYSTER SCADA TO ECS PRIMARY IEC:60870-104	See table 3P below																																																																															
	VLAN59	SMF	5	14	DATA LINK	Orlen Connections (See table 4)-Pri.	172.16.172.12																																																																															
	VLAN55	SMF	5	15	DATA LINK	HONEYWELL MULTI PURPOSE SERVER (MPS)-PRI. DMZ2 INTERNAL	172.16.170.10																																																																															
	VLAN52	SMF	5	16	DATA LINK	Honeywell Multi Purpose Server (MPS)-Pri. DMZ2 Secure	172.16.171.10																																																																															
	VLAN52	SMF	-	17	SPARE	SPARE	-																																																																															
	VLAN56	CAT6	5	18	DATA LINK	RAW WATER PUMP STATION PRIMARY (MODBUS)	172.16.180.2																																																																															
	VLAN57	SMF	5	19	DATA LINK	GAS SUPPLIER SCADA PRIMARY (OPC UA)	172.16.145.130																																																																															
C	VLAN70	CAT6	5	20	DATA LINK	System1 (OPC UA)	-																																																																															
	VLAN53	SMF	5	21	DATA LINK	GAS PIPELINE PLC1\2\3 PRIMARY-MODBUS	See table 2P below																																																																															
	VLAN53	SMF	-	22	SPARE	SPARE	-																																																																															
	VLAN53	SMF	-	23	SPARE	SPARE	-																																																																															
	VLAN53	SMF	-	24	SPARE	SPARE	-																																																																															
	STACK	STACKING	30	STACKING 1	EXT1-2:STACKING 2	EXTERNAL SWITCH 2	-																																																																															
	STACK	STACKING	30	STACKING 2	EXT1-2:STACKING 1	EXTERNAL SWITCH 2	-																																																																															
	Pwr Stack 9300	Pwr Stack 9300	31	STACKING 1	EXT1-2:Stack 2	Cisco 9300 24 Port External Switch Power Stacking	-																																																																															
	Pwr Stack 9300	Pwr Stack 9300	31	STACKING 2	EXT1-2:Stack 1	Cisco 9300 24 Port External Switch Power Stacking	-																																																																															
	D	NOTE: 1. DME IS INSTALLED IN EWS1SVR Table-1P:TO TT SOWE\LFC\DYSTER <table><thead><tr><th>LINK</th><th>IP</th></tr></thead><tbody><tr><td>SOWE-REAL</td><td>172.16.160.3</td></tr><tr><td>LFC-REAL</td><td>172.16.160.7</td></tr><tr><td>DYSTER\SCADA TSO</td><td>172.16.160.11</td></tr></tbody></table> Table-1S:TO TT SOWE\LFC\DYSTER <table><thead><tr><th>LINK</th><th>IP</th></tr></thead><tbody><tr><td>LFC-REAL</td><td>172.16.160.8</td></tr><tr><td>DYSTER\SCADA TSO</td><td>172.16.160.12</td></tr></tbody></table> Table-2P:GAS PIPLINE <table><thead><tr><th>LINK</th><th>IP</th></tr></thead><tbody><tr><td>PLC1:ZZU</td><td>10.151.198.118</td></tr><tr><td>PLC2:SOT</td><td>10.151.198.135</td></tr><tr><td>PLC3:SNT</td><td>10.151.198.103</td></tr></tbody></table> Table-2S:GAS PIPLINE <table><thead><tr><th>LINK</th><th>IP</th></tr></thead><tbody><tr><td>PLC1:ZZU</td><td>10.151.198.119</td></tr><tr><td>PLC2:SOT</td><td>10.151.198.136</td></tr><tr><td>PLC3:SNT</td><td>10.151.198.104</td></tr></tbody></table> Table-4:Multi Purpose Server(MPS) <table><thead><tr><th></th><th>DMZ2 Internal IP</th><th>DMZ2 External IP</th></tr></thead><tbody><tr><td>Hypervisor Management IP</td><td>10.151.103.2</td><td></td></tr><tr><td>RDP VM</td><td>10.151.103.3</td><td>172.16.171.3</td></tr><tr><td>SFTP VM</td><td>10.151.103.4</td><td>172.16.171.4</td></tr><tr><td>Log Forwarder VM</td><td>10.151.103.5</td><td>172.16.171.5</td></tr><tr><td>OP CUA VM</td><td>10.151.103.6</td><td>172.16.171.6</td></tr></tbody></table>															LINK	IP	SOWE-REAL	172.16.160.3	LFC-REAL	172.16.160.7	DYSTER\SCADA TSO	172.16.160.11	LINK	IP	LFC-REAL	172.16.160.8	DYSTER\SCADA TSO	172.16.160.12	LINK	IP	PLC1:ZZU	10.151.198.118	PLC2:SOT	10.151.198.135	PLC3:SNT	10.151.198.103	LINK	IP	PLC1:ZZU	10.151.198.119	PLC2:SOT	10.151.198.136	PLC3:SNT	10.151.198.104		DMZ2 Internal IP	DMZ2 External IP	Hypervisor Management IP	10.151.103.2		RDP VM	10.151.103.3	172.16.171.3	SFTP VM	10.151.103.4	172.16.171.4	Log Forwarder VM	10.151.103.5	172.16.171.5	OP CUA VM	10.151.103.6	172.16.171.6	D																					
LINK		IP																																																																																				
SOWE-REAL		172.16.160.3																																																																																				
LFC-REAL		172.16.160.7																																																																																				
DYSTER\SCADA TSO		172.16.160.11																																																																																				
LINK		IP																																																																																				
LFC-REAL		172.16.160.8																																																																																				
DYSTER\SCADA TSO		172.16.160.12																																																																																				
LINK		IP																																																																																				
PLC1:ZZU		10.151.198.118																																																																																				
PLC2:SOT	10.151.198.135																																																																																					
PLC3:SNT	10.151.198.103																																																																																					
LINK	IP																																																																																					
PLC1:ZZU	10.151.198.119																																																																																					
PLC2:SOT	10.151.198.136																																																																																					
PLC3:SNT	10.151.198.104																																																																																					
	DMZ2 Internal IP	DMZ2 External IP																																																																																				
Hypervisor Management IP	10.151.103.2																																																																																					
RDP VM	10.151.103.3	172.16.171.3																																																																																				
SFTP VM	10.151.103.4	172.16.171.4																																																																																				
Log Forwarder VM	10.151.103.5	172.16.171.5																																																																																				
OP CUA VM	10.151.103.6	172.16.171.6																																																																																				
E	CENTRAL CONTROL ROOM NLR Copyright © GE Vernova and/or its affiliates 2021-2025 All rights reserved. The information herein is proprietary information of GE Vernova and/or its affiliates.															E																																																																						
	F	GE VERNOVA Document Type: TECHNICAL DOCUMENT Document Title: ASSY, REMOTE CONTROL SYS Creation Date: 2021-10-28 Drawing Number: 302T0147 Revision: E Sheet: 4 of 27															F																																																																					
		1																																																																																				
		2																																																																																				
		3																																																																																				
		4																																																																																				
		5																																																																																				
		6																																																																																				
		7																																																																																				
		8																																																																																				
Non-Public Class II (Non Critical) - NLR																																																																																						


1		2		3		4		5		6		7		8	
A															
	Switch:		RTR1 (11CSA02GH017)		ID#:		18		Location:		SERVER ROOM - NETWORK CABINET 2				
	Part No:		117T6409P060AAAF				IP Address:		10.10.11.2						
	Type:		NETWORKST 4.0 ROUTER				Power Source:		UPS1						
	VLAN		MEDIA		ID#		PORT		DEVICE		DEVICE DESCRIPTION			IP ADDRESS	
	NA		CAT6		5		GE 0/0		SW-XDH-01 PORT1		XDH SWITCH			10.10.11.5	
	NA		CAT6		5		GE 0/1		RB1-1 PORT 24		ROOT BRIDGE			172.16.205.247	
B															
	Switch:		SW-XDH-01 (11CSA02GH015)		ID#:		19		Location:		SERVER ROOM - NETWORK CABINET 2				
	Part No:		117T6409P060AAAB				IP Address:		10.10.11.5						
	Type:		XDH SW				Power Source:		UPS1						
	VLAN		MEDIA		ID#		PORT		DEVICE		DEVICE DESCRIPTION			IP ADDRESS	
	Trunk		CAT6		5		1		RTR1:GE 0/0		4331 ROUTER			10.10.11.2	
C															
	Trunk		CAT6		5		2		UTM1:1		401E FIREWALL			10.10.11.4	
	Unavailable		Unavailable		-		3		RESERVED		-			-	
	Unavailable		Unavailable		-		4		RESERVED		-			-	
	Unavailable		Unavailable		-		5		RESERVED		-			-	
	Unavailable		Unavailable		-		6		RESERVED		-			-	
	Unavailable		Unavailable		-		7		RESERVED		-			-	
D															
	Unavailable		Unavailable		-		8		RESERVED		-			-	
	Unavailable		Unavailable		-		9		RESERVED		-			-	
	Unavailable		Unavailable		-		10		RESERVED		-			-	
	Unavailable		Unavailable		-		11		RESERVED		-			-	
	Unavailable		Unavailable		-		12		RESERVED		-			-	
	Unavailable		Unavailable		-		13		RESERVED		-			-	
E															
	Unavailable		Unavailable		-		14		RESERVED		-			-	
	Unavailable		Unavailable		-		15		RESERVED		-			-	
	Unavailable		Unavailable		-		16		RESERVED		-			-	
	Unavailable		Unavailable		-		17		RESERVED		-			-	
	Unavailable		Unavailable		-		18		RESERVED		-			-	
	Unavailable		Unavailable		-		19		RESERVED		-			-	
F															
	Unavailable		Unavailable		-		20		RESERVED		-			-	
	Unavailable		Unavailable		-		21		RESERVED		-			-	
	Unavailable		Unavailable		-		22		RESERVED		-			-	
	Unavailable		Unavailable		-		23		RESERVED		-			-	
	Trunk		CAT6		5		24		SW-XDH-02:24		XDH SWITCH COPPER TRUNK PORTS			10.10.11.6	
	Unavailable		Unavailable		-		25		RESERVED		-			-	

	1	2	3	4	5	6	7	8																																																																																																																																																																																																																																																																																			
A	<table><tr><th colspan="7">A</th></tr><tr><td>Switch:</td><td colspan="2">UTM1 (11CSA02GH013)</td><td>ID#:</td><td colspan="2">17</td><td>Location:</td><td colspan="2">SERVER ROOM - NETWORK CABINET 2</td></tr><tr><td>Part No:</td><td colspan="5">117T6409PX10ABAB</td><td>IP Address:</td><td colspan="2"></td></tr><tr><td>Type:</td><td colspan="5">UNIFIED THREAT MANAGER</td><td>Power Source:</td><td colspan="2">UPS1</td></tr><tr><th>VLAN</th><th>MEDIA</th><th>ID#</th><th>PORT</th><th>DEVICE</th><th>DEVICE DESCRIPTION</th><th colspan="2">IP ADDRESS</th></tr><tr><td>NA</td><td>CAT6</td><td>5</td><td>1</td><td>SW-XDH-01 PORT2</td><td>SW-XDH-01 PORT2</td><td colspan="2">10.10.11.4</td></tr><tr><td>NA</td><td>CAT6</td><td>5</td><td>2</td><td>SW2-1 PORT 24</td><td>GE DMZ (MDH)</td><td colspan="2">172.16.16.1</td></tr><tr><td>VLAN50</td><td>CAT6</td><td>5</td><td>3</td><td>EXT1-1 PORT 3</td><td>GE WAN</td><td colspan="2">192.168.254.253</td></tr><tr><td>NA</td><td>CAT6</td><td>-</td><td>4</td><td>AVAILABLE</td><td>-</td><td colspan="2">-</td></tr><tr><td>NA</td><td>CAT6</td><td>-</td><td>5</td><td>AVAILABLE</td><td>-</td><td colspan="2">-</td></tr><tr><td>NA</td><td>CAT6</td><td>-</td><td>6</td><td>AVAILABLE</td><td>-</td><td colspan="2">-</td></tr><tr><td>NA</td><td>CAT6</td><td>5</td><td>7</td><td>GE MONITORING</td><td>INTERFACE SETUP FOR M&D</td><td colspan="2">-</td></tr><tr><td>VLAN52</td><td>CAT6</td><td>5</td><td>8</td><td>EXT1-1 PORT 5</td><td>DMZ-2 MPS Secure</td><td colspan="2">172.16.171.1</td></tr><tr><td>VLAN51</td><td>CAT6</td><td>5</td><td>9</td><td>EXT1-1 PORT 8</td><td>EXTERNAL COMMUNICATION</td><td colspan="2">172.16.160.1</td></tr><tr><td>VLAN55</td><td>CAT6</td><td>5</td><td>10</td><td>EXT1-1 PORT 9</td><td>DMZ-2 MPS Internal</td><td colspan="2">172.16.170.1</td></tr><tr><td>VLAN56</td><td>CAT6</td><td>5</td><td>11</td><td>EXT1-1 PORT 10</td><td>EXTERNAL COMMUNICATION</td><td colspan="2">172.16.180.1</td></tr><tr><td>VLAN57</td><td>CAT6</td><td>5</td><td>12</td><td>EXT1-1 PORT 11</td><td>EXTERNAL COMMUNICATION</td><td colspan="2">172.16.190.1</td></tr><tr><td>VLAN58</td><td>CAT6</td><td>5</td><td>13</td><td>EXT1-1 PORT 7</td><td>EXTERNAL COMMUNICATION</td><td colspan="2">172.30.128.65</td></tr><tr><td>VLAN53</td><td>CAT6</td><td>5</td><td>14</td><td>EXT1-1 PORT 6</td><td>EXTERNAL COMMUNICATION</td><td colspan="2">10.151.198.101</td></tr><tr><td>VLAN70</td><td>CAT6</td><td>5</td><td>15</td><td>EXT1-1 PORT 4</td><td>EXTERNAL COMMUNICATION</td><td colspan="2">172.16.145.129</td></tr><tr><td>VLAN59</td><td>CAT6</td><td>5</td><td>16</td><td>Ext1-1 Port 1</td><td>EXTERNAL COMMUNICATION</td><td colspan="2">172.16.172.1</td></tr><tr><td>NA</td><td>SFP</td><td>-</td><td>17</td><td>AVAILABLE</td><td>SPARE INTERFACES FOR SFP's</td><td colspan="2">-</td></tr><tr><td>NA</td><td>SFP</td><td>-</td><td>18</td><td>AVAILABLE</td><td>SPARE INTERFACES FOR SFP's</td><td colspan="2">-</td></tr><tr><td>NA</td><td>SFP</td><td>-</td><td>19</td><td>AVAILABLE</td><td>SPARE INTERFACES FOR SFP's</td><td colspan="2">-</td></tr><tr><td>NA</td><td>SFP</td><td>-</td><td>20</td><td>AVAILABLE</td><td>SPARE INTERFACES FOR SFP's</td><td colspan="2">-</td></tr><tr><td>NA</td><td>SFP</td><td>-</td><td>21</td><td>AVAILABLE</td><td>SPARE INTERFACES FOR SFP's</td><td colspan="2">-</td></tr><tr><td>NA</td><td>SFP</td><td>-</td><td>22</td><td>AVAILABLE</td><td>SPARE INTERFACES FOR SFP's</td><td colspan="2">-</td></tr><tr><td>NA</td><td>SFP</td><td>-</td><td>23</td><td>AVAILABLE</td><td>SPARE A							Switch:	UTM1 (11CSA02GH013)		ID#:	17		Location:	SERVER ROOM - NETWORK CABINET 2		Part No:	117T6409PX10ABAB					IP Address:			Type:	UNIFIED THREAT MANAGER					Power Source:	UPS1		VLAN	MEDIA	ID#	PORT	DEVICE	DEVICE DESCRIPTION	IP ADDRESS		NA	CAT6	5	1	SW-XDH-01 PORT2	SW-XDH-01 PORT2	10.10.11.4		NA	CAT6	5	2	SW2-1 PORT 24	GE DMZ (MDH)	172.16.16.1		VLAN50	CAT6	5	3	EXT1-1 PORT 3	GE WAN	192.168.254.253		NA	CAT6	-	4	AVAILABLE	-	-		NA	CAT6	-	5	AVAILABLE	-	-		NA	CAT6	-	6	AVAILABLE	-	-		NA	CAT6	5	7	GE MONITORING	INTERFACE SETUP FOR M&D	-		VLAN52	CAT6	5	8	EXT1-1 PORT 5	DMZ-2 MPS Secure	172.16.171.1		VLAN51	CAT6	5	9	EXT1-1 PORT 8	EXTERNAL COMMUNICATION	172.16.160.1		VLAN55	CAT6	5	10	EXT1-1 PORT 9	DMZ-2 MPS Internal	172.16.170.1		VLAN56	CAT6	5	11	EXT1-1 PORT 10	EXTERNAL COMMUNICATION	172.16.180.1		VLAN57	CAT6	5	12	EXT1-1 PORT 11	EXTERNAL COMMUNICATION	172.16.190.1		VLAN58	CAT6	5	13	EXT1-1 PORT 7	EXTERNAL COMMUNICATION	172.30.128.65		VLAN53	CAT6	5	14	EXT1-1 PORT 6	EXTERNAL COMMUNICATION	10.151.198.101		VLAN70	CAT6	5	15	EXT1-1 PORT 4	EXTERNAL COMMUNICATION	172.16.145.129		VLAN59	CAT6	5	16	Ext1-1 Port 1	EXTERNAL COMMUNICATION	172.16.172.1		NA	SFP	-	17	AVAILABLE	SPARE INTERFACES FOR SFP's	-		NA	SFP	-	18	AVAILABLE	SPARE INTERFACES FOR SFP's	-		NA	SFP	-	19	AVAILABLE	SPARE INTERFACES FOR SFP's	-		NA	SFP	-	20	AVAILABLE	SPARE INTERFACES FOR SFP's	-		NA	SFP	-	21	AVAILABLE	SPARE INTERFACES FOR SFP's	-		NA	SFP	-	22	AVAILABLE	SPARE INTERFACES FOR SFP's	-		NA	SFP	-	23	AVAILABLE	SPARE INTERFACES FOR SFP's	-		NA	SFP	-	24	AVAILABLE	SPARE INTERFACES FOR SFP's	-		NA	SFP	-	25	AVAILABLE	SPARE INTERFACES FOR SFP's	-		NA	SFP	-	26	AVAILABLE	SPARE INTERFACES FOR SFP's	-		NA	SFP	-	27	AVAILABLE	SPARE INTERFACES FOR SFP's	-		NA	SFP	-	28	AVAILABLE	SPARE INTERFACES FOR SFP's	-		NA	CAT6	5	HA	HA LINK 1	TO UTM2 PORT HA	-		A
A																																																																																																																																																																																																																																																																																											
Switch:	UTM1 (11CSA02GH013)		ID#:	17		Location:	SERVER ROOM - NETWORK CABINET 2																																																																																																																																																																																																																																																																																				
Part No:	117T6409PX10ABAB					IP Address:																																																																																																																																																																																																																																																																																					
Type:	UNIFIED THREAT MANAGER					Power Source:	UPS1																																																																																																																																																																																																																																																																																				
VLAN	MEDIA	ID#	PORT	DEVICE	DEVICE DESCRIPTION	IP ADDRESS																																																																																																																																																																																																																																																																																					
NA	CAT6	5	1	SW-XDH-01 PORT2	SW-XDH-01 PORT2	10.10.11.4																																																																																																																																																																																																																																																																																					
NA	CAT6	5	2	SW2-1 PORT 24	GE DMZ (MDH)	172.16.16.1																																																																																																																																																																																																																																																																																					
VLAN50	CAT6	5	3	EXT1-1 PORT 3	GE WAN	192.168.254.253																																																																																																																																																																																																																																																																																					
NA	CAT6	-	4	AVAILABLE	-	-																																																																																																																																																																																																																																																																																					
NA	CAT6	-	5	AVAILABLE	-	-																																																																																																																																																																																																																																																																																					
NA	CAT6	-	6	AVAILABLE	-	-																																																																																																																																																																																																																																																																																					
NA	CAT6	5	7	GE MONITORING	INTERFACE SETUP FOR M&D	-																																																																																																																																																																																																																																																																																					
VLAN52	CAT6	5	8	EXT1-1 PORT 5	DMZ-2 MPS Secure	172.16.171.1																																																																																																																																																																																																																																																																																					
VLAN51	CAT6	5	9	EXT1-1 PORT 8	EXTERNAL COMMUNICATION	172.16.160.1																																																																																																																																																																																																																																																																																					
VLAN55	CAT6	5	10	EXT1-1 PORT 9	DMZ-2 MPS Internal	172.16.170.1																																																																																																																																																																																																																																																																																					
VLAN56	CAT6	5	11	EXT1-1 PORT 10	EXTERNAL COMMUNICATION	172.16.180.1																																																																																																																																																																																																																																																																																					
VLAN57	CAT6	5	12	EXT1-1 PORT 11	EXTERNAL COMMUNICATION	172.16.190.1																																																																																																																																																																																																																																																																																					
VLAN58	CAT6	5	13	EXT1-1 PORT 7	EXTERNAL COMMUNICATION	172.30.128.65																																																																																																																																																																																																																																																																																					
VLAN53	CAT6	5	14	EXT1-1 PORT 6	EXTERNAL COMMUNICATION	10.151.198.101																																																																																																																																																																																																																																																																																					
VLAN70	CAT6	5	15	EXT1-1 PORT 4	EXTERNAL COMMUNICATION	172.16.145.129																																																																																																																																																																																																																																																																																					
VLAN59	CAT6	5	16	Ext1-1 Port 1	EXTERNAL COMMUNICATION	172.16.172.1																																																																																																																																																																																																																																																																																					
NA	SFP	-	17	AVAILABLE	SPARE INTERFACES FOR SFP's	-																																																																																																																																																																																																																																																																																					
NA	SFP	-	18	AVAILABLE	SPARE INTERFACES FOR SFP's	-																																																																																																																																																																																																																																																																																					
NA	SFP	-	19	AVAILABLE	SPARE INTERFACES FOR SFP's	-																																																																																																																																																																																																																																																																																					
NA	SFP	-	20	AVAILABLE	SPARE INTERFACES FOR SFP's	-																																																																																																																																																																																																																																																																																					
NA	SFP	-	21	AVAILABLE	SPARE INTERFACES FOR SFP's	-																																																																																																																																																																																																																																																																																					
NA	SFP	-	22	AVAILABLE	SPARE INTERFACES FOR SFP's	-																																																																																																																																																																																																																																																																																					
NA	SFP	-	23	AVAILABLE	SPARE INTERFACES FOR SFP's	-																																																																																																																																																																																																																																																																																					
NA	SFP	-	24	AVAILABLE	SPARE INTERFACES FOR SFP's	-																																																																																																																																																																																																																																																																																					
NA	SFP	-	25	AVAILABLE	SPARE INTERFACES FOR SFP's	-																																																																																																																																																																																																																																																																																					
NA	SFP	-	26	AVAILABLE	SPARE INTERFACES FOR SFP's	-																																																																																																																																																																																																																																																																																					
NA	SFP	-	27	AVAILABLE	SPARE INTERFACES FOR SFP's	-																																																																																																																																																																																																																																																																																					
NA	SFP	-	28	AVAILABLE	SPARE INTERFACES FOR SFP's	-																																																																																																																																																																																																																																																																																					
NA	CAT6	5	HA	HA LINK 1	TO UTM2 PORT HA	-																																																																																																																																																																																																																																																																																					
B	<table><tr><th colspan="7">B</th></tr><tr><td>Switch:</td><td colspan="2">UTM2 (11CSA02GH014)</td><td>ID#:</td><td colspan="2">17</td><td>Location:</td><td colspan="2">SERVER ROOM - NETWORK CABINET 2</td></tr><tr><td>Part No:</td><td colspan="5">117T6409PX11ABAB</td><td>IP Address:</td><td colspan="2"></td></tr><tr><td>Type:</td><td colspan="5">UNIFIED THREAT MANAGER – ID#17</td><td>Power Source:</td><td colspan="2">UPS2</td></tr><tr><th>VLAN</th><th>MEDIA</th><th>ID#</th><th>PORT</th><th>DEVICE</th><th>DEVICE DESCRIPTION</th><th colspan="2">IP ADDRESS</th></tr><tr><td>NA</td><td>CAT6</td><td>5</td><td>1</td><td>SW-XDH-02 PORT2</td><td>SW-XDH-02 PORT2</td><td colspan="2">10.10.11.4</td></tr><tr><td>NA</td><td>CAT6</td><td>5</td><td>2</td><td>SW2-2 PORT 24</td><td>GE DMZ (MDH)</td><td colspan="2">172.16.16.1</td></tr><tr><td>VLAN50</td><td>CAT6</td><td>5</td><td>3</td><td>EXT1-2 PORT 3</td><td>GE WAN</td><td colspan="2">192.168.254.253</td></tr><tr><td>NA</td><td>CAT6</td><td>-</td><td>4</td><td>AVAILABLE</td><td>-</td><td colspan="2">-</td></tr><tr><td>NA</td><td>CAT6</td><td>-</td><td>5</td><td>AVAILABLE</td><td>-</td><td colspan="2">-</td></tr><tr><td>NA</td><td>CAT6</td><td>-</td><td>6</td><td>AVAILABLE</td><td>-</td><td colspan="2">-</td></tr><tr><td>NA</td><td>CAT6</td><td>5</td><td>7</td><td>GE MONITORING</td><td>INTERFACE SETUP FOR M&D</td><td colspan="2">-</td></tr><tr><td>VLAN52</td><td>CAT6</td><td>5</td><td>8</td><td>EXT1-2 PORT 5</td><td>DMZ-2 MPS Secure</td><td colspan="2">172.16.171.1</td></tr><tr><td>VLAN51</td><td>CAT6</td><td>5</td><td>9</td><td>EXT1-2 PORT 8</td><td>EXTERNAL COMMUNICATION</td><td colspan="2">172.16.160.1</td></tr><tr><td>VLAN55</td><td>CAT6</td><td>5</td><td>10</td><td>EXT1-2 PORT 9</td><td>DMZ-2 MPS Internal</td><td colspan="2">172.16.170.1</td></tr><tr><td>VLAN56</td><td>CAT6</td><td>5</td><td>11</td><td>EXT1-2 PORT 10</td><td>EXTERNAL COMMUNICATION</td><td colspan="2">172.16.180.1</td></tr><tr><td>VLAN57</td><td>CAT6</td><td>5</td><td>12</td><td>EXT1-2 PORT 11</td><td>EXTERNAL COMMUNICATION</td><td colspan="2">172.16.190.1</td></tr><tr><td>VLAN58</td><td>CAT6</td><td>5</td><td>13</td><td>EXT1-2 PORT 7</td><td>EXTERNAL COMMUNICATION</td><td colspan="2">172.30.128.65</td></tr><tr><td>VLAN53</td><td>CAT6</td><td>5</td><td>14</td><td>EXT1-2 PORT 6</td><td>EXTERNAL COMMUNICATION</td><td colspan="2">10.151.198.101</td></tr><tr><td>VLAN70</td><td>CAT6</td><td>5</td><td>15</td><td>EXT1-2 PORT 4</td><td>EXTERNAL COMMUNICATION</td><td colspan="2">172.16.145.129</td></tr><tr><td>VLAN59</td><td>CAT6</td><td>5</td><td>16</td><td>Ext1-2 Port 1</td><td>EXTERNAL COMMUNICATION</td><td colspan="2">172.16.172.1</td></tr><tr><td>NA</td><td>SFP</td><td>-</td><td>17</td><td>AVAILABLE</td><td>SPARE INTERFACES FOR SFP's</td><td colspan="2">-</td></tr><tr><td>NA</td><td>SFP</td><td>-</td><td>18</td><td>AVAILABLE</td><td>SPARE INTERFACES FOR SFP's</td><td colspan="2">-</td></tr><tr><td>NA</td><td>SFP</td><td>-</td><td>19</td><td>AVAILABLE</td><td>SPARE INTERFACES FOR SFP's</td><td colspan="2">-</td></tr><tr><td>NA</td><td>SFP</td><td>-</td><td>20</td><td>AVAILABLE</td><td>SPARE INTERFACES FOR SFP's</td><td colspan="2">-</td></tr><tr><td>NA</td><td>SFP</td><td>-</td><td>21</td><td>AVAILABLE</td><td>SPARE INTERFACES FOR SFP's</td><td colspan="2">-</td></tr><tr><td>NA</td><td>SFP</td><td>-</td><td>22</td><td>AVAILABLE</td><td>SPARE INTERFACES FOR SFP's</td><td colspan="2">-</td></tr><tr><td>NA</td><td>SFP</td><td>-</td><UTM1 PORT HA</td><td colspan="2">-</td></tr></table>								B							Switch:	UTM2 (11CSA02GH014)		ID#:	17		Location:	SERVER ROOM - NETWORK CABINET 2		Part No:	117T6409PX11ABAB					IP Address:			Type:	UNIFIED THREAT MANAGER – ID#17					Power Source:	UPS2		VLAN	MEDIA	ID#	PORT	DEVICE	DEVICE DESCRIPTION	IP ADDRESS		NA	CAT6	5	1	SW-XDH-02 PORT2	SW-XDH-02 PORT2	10.10.11.4		NA	CAT6	5	2	SW2-2 PORT 24	GE DMZ (MDH)	172.16.16.1		VLAN50	CAT6	5	3	EXT1-2 PORT 3	GE WAN	192.168.254.253		NA	CAT6	-	4	AVAILABLE	-	-		NA	CAT6	-	5	AVAILABLE	-	-		NA	CAT6	-	6	AVAILABLE	-	-		NA	CAT6	5	7	GE MONITORING	INTERFACE SETUP FOR M&D	-		VLAN52	CAT6	5	8	EXT1-2 PORT 5	DMZ-2 MPS Secure	172.16.171.1		VLAN51	CAT6	5	9	EXT1-2 PORT 8	EXTERNAL COMMUNICATION	172.16.160.1		VLAN55	CAT6	5	10	EXT1-2 PORT 9	DMZ-2 MPS Internal	172.16.170.1		VLAN56	CAT6	5	11	EXT1-2 PORT 10	EXTERNAL COMMUNICATION	172.16.180.1		VLAN57	CAT6	5	12	EXT1-2 PORT 11	EXTERNAL COMMUNICATION	172.16.190.1		VLAN58	CAT6	5	13	EXT1-2 PORT 7	EXTERNAL COMMUNICATION	172.30.128.65		VLAN53	CAT6	5	14	EXT1-2 PORT 6	EXTERNAL COMMUNICATION	10.151.198.101		VLAN70	CAT6	5	15	EXT1-2 PORT 4	EXTERNAL COMMUNICATION	172.16.145.129		VLAN59	CAT6	5	16	Ext1-2 Port 1	EXTERNAL COMMUNICATION	172.16.172.1		NA	SFP	-	17	AVAILABLE	SPARE INTERFACES FOR SFP's	-		NA	SFP	-	18	AVAILABLE	SPARE INTERFACES FOR SFP's	-		NA	SFP	-	19	AVAILABLE	SPARE INTERFACES FOR SFP's	-		NA	SFP	-	20	AVAILABLE	SPARE INTERFACES FOR SFP's	-		NA	SFP	-	21	AVAILABLE	SPARE INTERFACES FOR SFP's	-		NA	SFP	-	22	AVAILABLE	SPARE INTERFACES FOR SFP's	-		NA	SFP	-	23	AVAILABLE	SPARE INTERFACES FOR SFP's	-		NA	SFP	-	24	AVAILABLE	SPARE INTERFACES FOR SFP's	-		NA	SFP	-	25	AVAILABLE	SPARE INTERFACES FOR SFP's	-		NA	SFP	-	26	AVAILABLE	SPARE INTERFACES FOR SFP's	-		NA	SFP	-	27	AVAILABLE	SPARE INTERFACES FOR SFP's	-		NA	SFP	-	28	AVAILABLE	SPARE INTERFACES FOR SFP's	-		NA	CAT6	5	HA	HA LINK 1	TO UTM1 PORT HA	-		B
B																																																																																																																																																																																																																																																																																											
Switch:	UTM2 (11CSA02GH014)		ID#:	17		Location:	SERVER ROOM - NETWORK CABINET 2																																																																																																																																																																																																																																																																																				
Part No:	117T6409PX11ABAB					IP Address:																																																																																																																																																																																																																																																																																					
Type:	UNIFIED THREAT MANAGER – ID#17					Power Source:	UPS2																																																																																																																																																																																																																																																																																				
VLAN	MEDIA	ID#	PORT	DEVICE	DEVICE DESCRIPTION	IP ADDRESS																																																																																																																																																																																																																																																																																					
NA	CAT6	5	1	SW-XDH-02 PORT2	SW-XDH-02 PORT2	10.10.11.4																																																																																																																																																																																																																																																																																					
NA	CAT6	5	2	SW2-2 PORT 24	GE DMZ (MDH)	172.16.16.1																																																																																																																																																																																																																																																																																					
VLAN50	CAT6	5	3	EXT1-2 PORT 3	GE WAN	192.168.254.253																																																																																																																																																																																																																																																																																					
NA	CAT6	-	4	AVAILABLE	-	-																																																																																																																																																																																																																																																																																					
NA	CAT6	-	5	AVAILABLE	-	-																																																																																																																																																																																																																																																																																					
NA	CAT6	-	6	AVAILABLE	-	-																																																																																																																																																																																																																																																																																					
NA	CAT6	5	7	GE MONITORING	INTERFACE SETUP FOR M&D	-																																																																																																																																																																																																																																																																																					
VLAN52	CAT6	5	8	EXT1-2 PORT 5	DMZ-2 MPS Secure	172.16.171.1																																																																																																																																																																																																																																																																																					
VLAN51	CAT6	5	9	EXT1-2 PORT 8	EXTERNAL COMMUNICATION	172.16.160.1																																																																																																																																																																																																																																																																																					
VLAN55	CAT6	5	10	EXT1-2 PORT 9	DMZ-2 MPS Internal	172.16.170.1																																																																																																																																																																																																																																																																																					
VLAN56	CAT6	5	11	EXT1-2 PORT 10	EXTERNAL COMMUNICATION	172.16.180.1																																																																																																																																																																																																																																																																																					
VLAN57	CAT6	5	12	EXT1-2 PORT 11	EXTERNAL COMMUNICATION	172.16.190.1																																																																																																																																																																																																																																																																																					
VLAN58	CAT6	5	13	EXT1-2 PORT 7	EXTERNAL COMMUNICATION	172.30.128.65																																																																																																																																																																																																																																																																																					
VLAN53	CAT6	5	14	EXT1-2 PORT 6	EXTERNAL COMMUNICATION	10.151.198.101																																																																																																																																																																																																																																																																																					
VLAN70	CAT6	5	15	EXT1-2 PORT 4	EXTERNAL COMMUNICATION	172.16.145.129																																																																																																																																																																																																																																																																																					
VLAN59	CAT6	5	16	Ext1-2 Port 1	EXTERNAL COMMUNICATION	172.16.172.1																																																																																																																																																																																																																																																																																					
NA	SFP	-	17	AVAILABLE	SPARE INTERFACES FOR SFP's	-																																																																																																																																																																																																																																																																																					
NA	SFP	-	18	AVAILABLE	SPARE INTERFACES FOR SFP's	-																																																																																																																																																																																																																																																																																					
NA	SFP	-	19	AVAILABLE	SPARE INTERFACES FOR SFP's	-																																																																																																																																																																																																																																																																																					
NA	SFP	-	20	AVAILABLE	SPARE INTERFACES FOR SFP's	-																																																																																																																																																																																																																																																																																					
NA	SFP	-	21	AVAILABLE	SPARE INTERFACES FOR SFP's	-																																																																																																																																																																																																																																																																																					
NA	SFP	-	22	AVAILABLE	SPARE INTERFACES FOR SFP's	-																																																																																																																																																																																																																																																																																					
NA	SFP	-	23	AVAILABLE	SPARE INTERFACES FOR SFP's	-																																																																																																																																																																																																																																																																																					
NA	SFP	-	24	AVAILABLE	SPARE INTERFACES FOR SFP's	-																																																																																																																																																																																																																																																																																					
NA	SFP	-	25	AVAILABLE	SPARE INTERFACES FOR SFP's	-																																																																																																																																																																																																																																																																																					
NA	SFP	-	26	AVAILABLE	SPARE INTERFACES FOR SFP's	-																																																																																																																																																																																																																																																																																					
NA	SFP	-	27	AVAILABLE	SPARE INTERFACES FOR SFP's	-																																																																																																																																																																																																																																																																																					
NA	SFP	-	28	AVAILABLE	SPARE INTERFACES FOR SFP's	-																																																																																																																																																																																																																																																																																					
NA	CAT6	5	HA	HA LINK 1	TO UTM1 PORT HA	-																																																																																																																																																																																																																																																																																					
C									C																																																																																																																																																																																																																																																																																		
D									D																																																																																																																																																																																																																																																																																		
E									E																																																																																																																																																																																																																																																																																		
F	CENTRAL CONTROL ROOM NLR Copyright © GE Vernova and/or its affiliates 2021-2025 All rights reserved. The information herein is proprietary information of GE Vernova and/or its affiliates.  GE VERNOVA Document Type: TECHNICAL DOCUMENT Document Title: ASSY, REMOTE CONTROL SYS Creation Date: 2021-10-28 Drawing Number: 302T0147 Revision: E Sheet: 6 of 27								F																																																																																																																																																																																																																																																																																		
	1	2	3	4	5	6	7	8																																																																																																																																																																																																																																																																																			

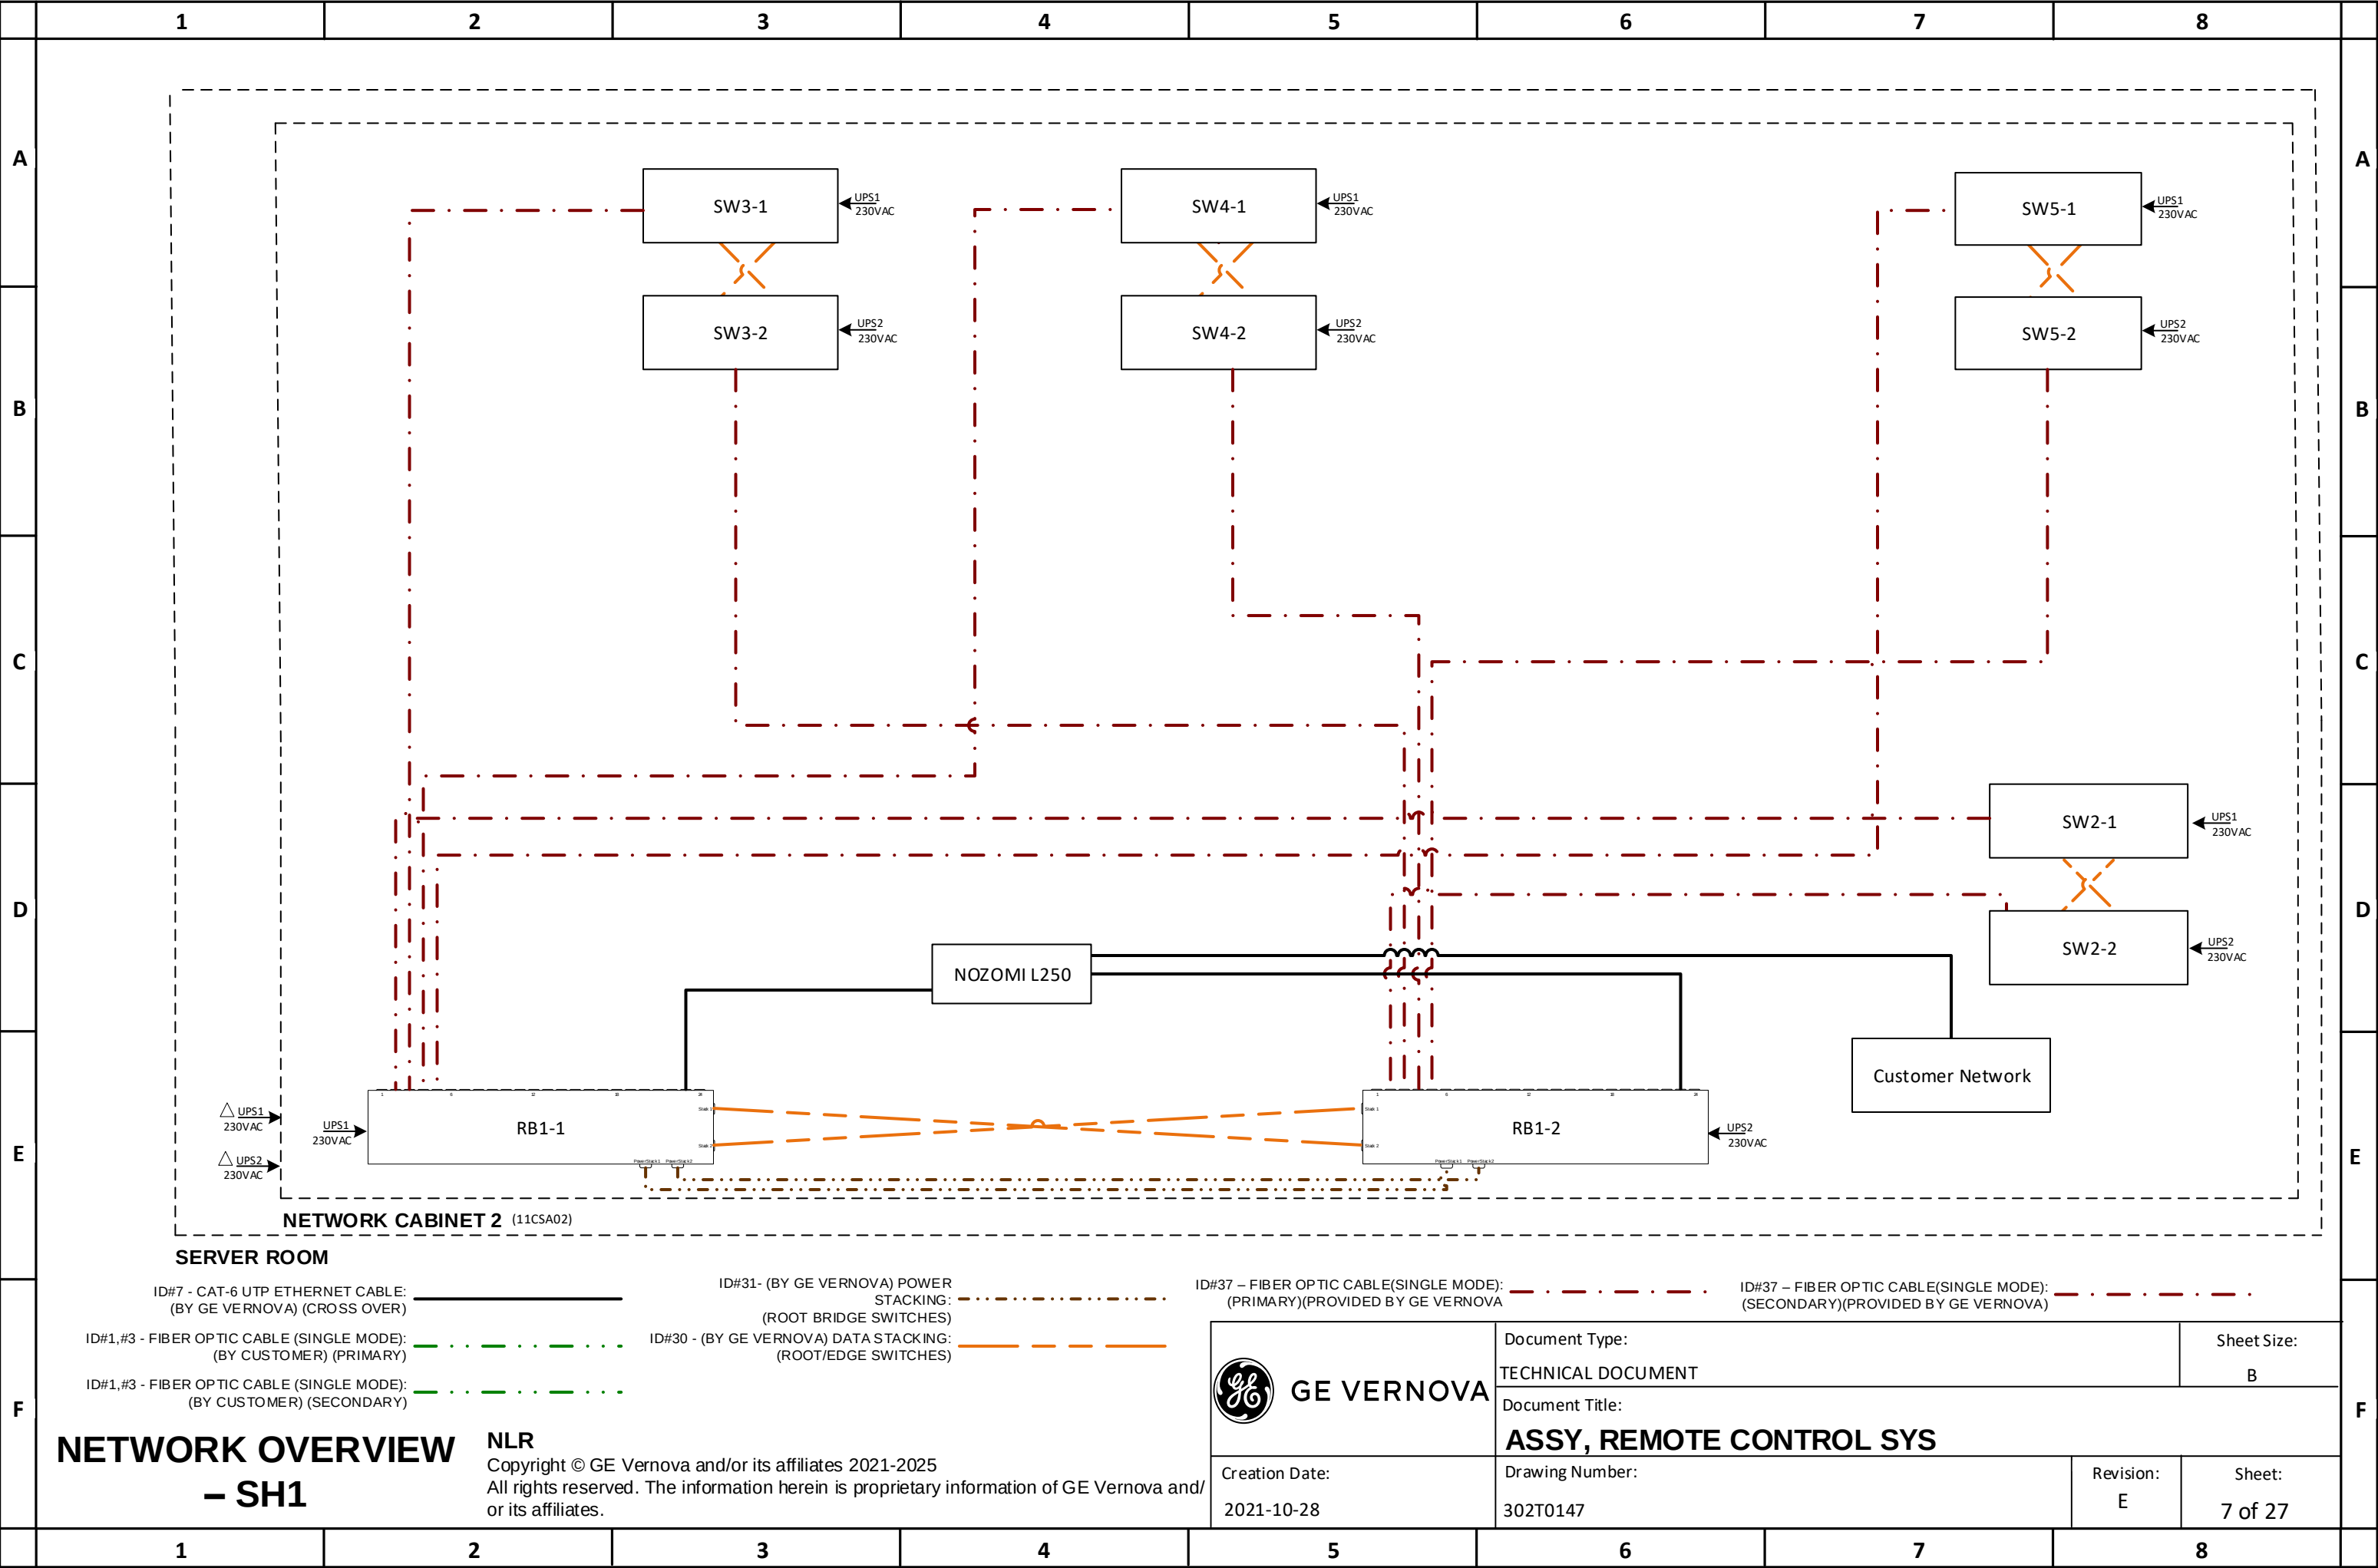

																																																																																																																																																																																																																																																																																																																																																																																																																																																																																																																																																																																																																																																																																																																																																																																																																																																																																																																																																																																																																																																																																																																																																																																																																																																																																																																																																																																																																																																																																																																																																																																																																																																																																																																																																																																																																																																																																																																																																																																																																																																																																																																																																																																																																																																																																																																																																																																																																																																																																																																																																																																																																																																																																																																																																																																																																																																																																																																																																																																																																																																																																																																																																																																																																																																																																																																																																																																																																																																																																																																																																																																																																																																																																																																																																																																																																																																																																																																																																																																																																																																																																																																																																																																																																																																																																																																																																																																																																																																																																																																																																																																																																																																																																																																																																																																																																																																																																																																																																																																																																																																																																																																																																																																																																																																																																																																																																																																																																																																																																																																																																																																																																																																																																																																																																																																																																																																																																																																																																																																																																																																																																																				</									
--	--	----	--	--	--	--	--	--	--	--	--

		1		2		3		4		5		6		7		8					
A																				A	

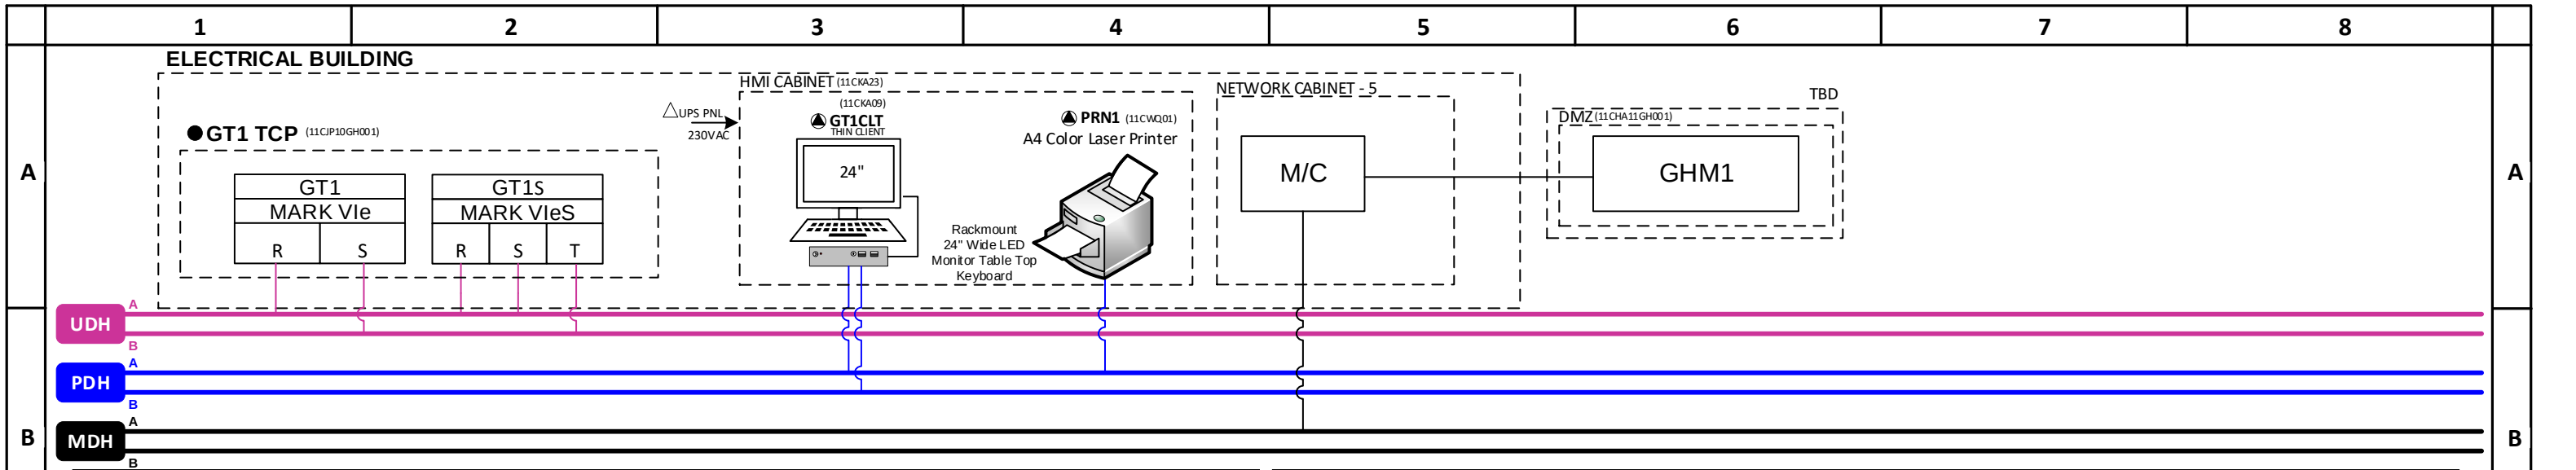

A						
Switch:	SW6-1 (11CSA05GH003)	ID#:	33		Location:	ELECTRICAL BUILDING - NETWORK CABINET 5
Part No:	117T6409P36RCAAB				IP Address:	172.16.202.6
Type:	SMF VLAN STACKED EDGE SW WITH 4SFP				Power Source:	UPS1
VLAN	MEDIA	ID#	PORT	DEVICE	DEVICE DESCRIPTION	IP ADDRESS
PDH	CAT6	-	1	SPARE	-	-
PDH	CAT6	6	2	GT1CLT:1	THIN CLIENT - PRIMARY	172.16.200.1
PDH	CAT6	-	3	SPARE	-	-
PDH	CAT6	5	4	PRN1	A4 COLOR LASER PRINTER	172.16.205.40
PDH	CAT6	-	5	SPARE	-	-
PDH	CAT6	-	6	SPARE	-	-
PDH	CAT6	-	7	SPARE	-	-
PDH	CAT6	-	8	SPARE	-	-
PDH	CAT6	-	9	SPARE	-	-
PDH	CAT6	-	10	SPARE	-	-
UDH	CAT6	7	11	GT1:R	GT1 <R> CONTROLLER	172.16.101.111
UDH	CAT6	7	12	GT1S:R	GT1S <R> CONTROLLER	172.16.101.135
UDH	CAT6	-	13	SPARE	-	-
UDH	CAT6	-	14	SPARE	-	-
UDH	CAT6	-	15	SPARE	-	-
UDH	CAT6	-	16	SPARE	-	-
UDH	CAT6	-	17	SPARE	-	-
UDH	CAT6	-	18	SPARE	-	-
UDH	CAT6	-	19	SPARE	-	-
SPAN	CAT6	-	20	SPARE	-	-
UDH	CAT6	-	21	SPARE	-	-
UDH	CAT6	-	22	SPARE	-	-
MDH	CAT6	5	23	GHM	GHM	172.16.16.54
MDH	CAT6	-	24	SPARE	-	-
Trunk	SMF	37	G1	RB1-1:6	SMF VLAN STACKED ROOT BRIDGE SW (CCR)	172.16.205.247
Trunk	SMF	-	G2	SPARE	-	-
Trunk	SMF	-	G3	SPARE	-	-
Trunk	SMF	-	G4	SPARE	-	-
STACK	STACKING	30	STACKING 1	SW6-2: STACKING 2	9200L EDGE SWITCH	-
STACK	STACKING	30	STACKING 2	SW6-2: STACKING 1	9200L EDGE SWITCH	-

B						
Switch:	SW6-2 (11CSA05GH004)	ID#:	33		Location:	ELECTRICAL BUILDING - NETWORK CABINET 5
Part No:	117T6409P36RCAAB				IP Address:	172.16.202.6
Type:	SMF VLAN STACKED EDGE SW WITH 4SFP				Power Source:	UPS2
VLAN	MEDIA	ID#	PORT	DEVICE	DEVICE DESCRIPTION	IP ADDRESS
PDH	CAT6	-	1	SPARE	-	-
PDH	CAT6	6	2	GT1CLT:2	THIN CLIENT - SECONDARY	172.16.200.1
PDH	CAT6	-	3	SPARE	-	-
PDH	CAT6	-	4	SPARE	-	-
PDH	CAT6	-	5	SPARE	-	-
PDH	CAT6	-	6	SPARE	-	-
PDH	CAT6	-	7	SPARE	-	-
PDH	CAT6	-	8	SPARE	-	-
PDH	CAT6	-	9	SPARE	-	-
PDH	CAT6	-	10	SPARE	-	-
UDH	CAT6	7	11	GT1:S	GT1<S> CONTROLLER	172.16.101.112
UDH	CAT6	7	12	GT1S:S	GT1S<S> CONTROLLER	172.16.101.136
UDH	CAT6	7	13	GT1S:T	GT1S<T> CONTROLLER	172.16.101.137
UDH	CAT6	-	14	SPARE	-	-
UDH	CAT6	-	15	SPARE	-	-
UDH	CAT6	-	16	SPARE	-	-
UDH	CAT6	-	17	SPARE	-	-
UDH	CAT6	-	18	SPARE	-	-
UDH	CAT6	-	19	SPARE	-	-
SPAN	CAT6	-	20	SPARE	-	-
UDH	CAT6	-	21	SPARE	-	-
UDH	CAT6	-	22	SPARE	-	-
MDH	CAT6	-	23	SPARE	-	-
MDH	CAT6	-	24	SPARE	-	-
Trunk	SMF	37	G1	RB1-2:6	SMF VLAN STACKED ROOT BRIDGE SW (CCR)	172.16.205.247
Trunk	SMF	-	G2	SPARE	-	-
Trunk	SMF	-	G3	SPARE	-	-
Trunk	SMF	-	G4	SPARE	-	-
STACK	STACKING	30	STACKING 1	SW6-1: STACKING 2	9200L EDGE SWITCH	-
STACK	STACKING	30	STACKING 2	SW6-1: STACKING 1	9200L EDGE SWITCH	-

F	ELECTRICAL BUILDING				NLR Copyright © GE Vernova and/or its affiliates 2021-2025 All rights reserved. The information herein is proprietary information of GE Vernova and/or its affiliates.				 GE VERNOVA		Document Type:		Sheet Size:		F
											TECHNICAL DOCUMENT		B		
											Document Title:				
Creation Date:		2021-10-28		Drawing Number:		302T0147		Revision:		E		Sheet:		11 of 27	
1		2		3		4		5		6		7		8	
Non-Public - Class II (Non-Critical) - NLR															


		1		2		3		4		5		6		7		8																																																																																																																																																																																																																																																																									
A		GT1 LEC (11MKC10GH001) E1 EX2100e M1 M2 C (11BPA10GH001) L1 LS2100e UDH PDH MDH																A																																																																																																																																																																																																																																																																							
B																		B																																																																																																																																																																																																																																																																							
C		<table><thead><tr><th colspan="7">A</th></tr><tr><td>Switch:</td><td colspan="2">SW7-1 (11CSA07GH001)</td><td>ID#:</td><td colspan="2">33</td><td>Location:</td><td colspan="4">LEC BUILDING – NETWORK RACK</td></tr><tr><td>Part No:</td><td colspan="4">117T6409P36RCAAB</td><td>IP Address:</td><td colspan="4">172.16.202.7</td></tr><tr><td>Type:</td><td colspan="4">SMF VLAN STACKED EDGE SW WITH 4SFP</td><td>Power Source:</td><td colspan="4">UPS1</td></tr><tr><th>VLAN</th><th>MEDIA</th><th>ID#</th><th>PORT</th><th>DEVICE</th><th>DEVICE DESCRIPTION</th><th>IP ADDRESS</th></tr></thead><tbody><tr><td>PDH</td><td>CAT6</td><td>-</td><td>1</td><td>SPARE</td><td>-</td><td>-</td></tr><tr><td>PDH</td><td>CAT6</td><td>-</td><td>2</td><td>SPARE</td><td>-</td><td>-</td></tr><tr><td>PDH</td><td>CAT6</td><td>-</td><td>3</td><td>SPARE</td><td>-</td><td>-</td></tr><tr><td>PDH</td><td>CAT6</td><td>-</td><td>4</td><td>SPARE</td><td>-</td><td>-</td></tr><tr><td>PDH</td><td>CAT6</td><td>-</td><td>5</td><td>SPARE</td><td>-</td><td>-</td></tr><tr><td>PDH</td><td>CAT6</td><td>-</td><td>6</td><td>SPARE</td><td>-</td><td>-</td></tr><tr><td>PDH</td><td>CAT6</td><td>-</td><td>7</td><td>SPARE</td><td>-</td><td>-</td></tr><tr><td>PDH</td><td>CAT6</td><td>-</td><td>8</td><td>SPARE</td><td>-</td><td>-</td></tr><tr><td>PDH</td><td>CAT6</td><td>-</td><td>9</td><td>SPARE</td><td>-</td><td>-</td></tr><tr><td>PDH</td><td>CAT6</td><td>-</td><td>10</td><td>SPARE</td><td>-</td><td>-</td></tr><tr><td>UDH</td><td>CAT6</td><td>-</td><td>11</td><td>SPARE</td><td>-</td><td>-</td></tr><tr><td>UDH</td><td>CAT6</td><td>-</td><td>12</td><td>SPARE</td><td>-</td><td>-</td></tr><tr><td>UDH</td><td>CAT6</td><td>-</td><td>13</td><td>SPARE</td><td>-</td><td>-</td></tr><tr><td>UDH</td><td>CAT6</td><td>-</td><td>14</td><td>SPARE</td><td>-</td><td>-</td></tr><tr><td>UDH</td>d><td>SPARE</td><td>-</td><td>-</td></tr><tr><td>MDH</td><td>CAT6</td><td>-</td><td>23</td><td>SPARE</td><td>-</td><td>-</td></tr><tr><td>MDH</td><td>CAT6</td><td>-</td><td>24</td><td>SPARE</td><td>-</td><td>172.16.16.1</td></tr><tr><td>Trunk</td><td>SMF</td><td>37</td><td>G1</td><td>RB1-1:7</td><td>SMF VLAN STACKED ROOT BRIDGE SW (CCR)</td><td>172.16.205.247</td></tr><tr><td>Trunk</td><td>SMF</td><td>-</td><td>G2</td><td>SPARE</td><td>-</td><td>-</td></tr><tr><td>Trunk</td><td>SMF</td><td>-</td><td>G3</td><td>SPARE</td><td>-</td><td>-</td></tr><tr><td>Trunk</td><td>SMF</td><td>-</td><td>G4</td><td>SPARE</td><td>-</td><td>-</td></tr><tr><td>STACK</td><td>STACKING</td><td>30</td><td>STACKING 1</td><td>SW7-2: STACKING 2</td><td>9200L EDGE SWITCH</td><td>-</td></tr><tr><td>STACK</td><td>STACKING</td><td>30</td><td>STACKING 2</td><td>SW7-2: STACKING 1</td><td>9200L EDGE SWITCH</td><td>-</td></tr></tbody></table>																A							Switch:	SW7-1 (11CSA07GH001)		ID#:	33		Location:	LEC BUILDING – NETWORK RACK				Part No:	117T6409P36RCAAB				IP Address:	172.16.202.7				Type:	SMF VLAN STACKED EDGE SW WITH 4SFP				Power Source:	UPS1				VLAN	MEDIA	ID#	PORT	DEVICE	DEVICE DESCRIPTION	IP ADDRESS	PDH	CAT6	-	1	SPARE	-	-	PDH	CAT6	-	2	SPARE	-	-	PDH	CAT6	-	3	SPARE	-	-	PDH	CAT6	-	4	SPARE	-	-	PDH	CAT6	-	5	SPARE	-	-	PDH	CAT6	-	6	SPARE	-	-	PDH	CAT6	-	7	SPARE	-	-	PDH	CAT6	-	8	SPARE	-	-	PDH	CAT6	-	9	SPARE	-	-	PDH	CAT6	-	10	SPARE	-	-	UDH	CAT6	-	11	SPARE	-	-	UDH	CAT6	-	12	SPARE	-	-	UDH	CAT6	-	13	SPARE	-	-	UDH	CAT6	-	14	SPARE	-	-	UDH	CAT6	7	14	E1:KEYPAD	E1 - KEYPAD	172.16.101.119	UDH	CAT6	7	15	E1:M1	E1 - M1 - CONTROLLER	172.16.101.116	UDH	CAT6	-	16	SPARE	-	-	UDH	CAT6	7	17	L1	GT1 STATIC STARTER – LS2100e	172.16.101.110	UDH	CAT6	-	18	SPARE	-	-	UDH	CAT6	-	19	SPARE	-	-	UDH	CAT6	-	20	SPARE	-	-	UDH	CAT6	-	21	SPARE	-	-	UDH	CAT6	-	22	SPARE	-	-	MDH	CAT6	-	23	SPARE	-	-	MDH	CAT6	-	24	SPARE	-	172.16.16.1	Trunk	SMF	37	G1	RB1-1:7	SMF VLAN STACKED ROOT BRIDGE SW (CCR)	172.16.205.247	Trunk	SMF	-	G2	SPARE	-	-	Trunk	SMF	-	G3	SPARE	-	-	Trunk	SMF	-	G4	SPARE	-	-	STACK	STACKING	30	STACKING 1	SW7-2: STACKING 2	9200L EDGE SWITCH	-	STACK	STACKING	30	STACKING 2	SW7-2: STACKING 1	9200L EDGE SWITCH	-	C	
		A																																																																																																																																																																																																																																																																																							
		Switch:	SW7-1 (11CSA07GH001)		ID#:	33		Location:	LEC BUILDING – NETWORK RACK																																																																																																																																																																																																																																																																																
		Part No:	117T6409P36RCAAB				IP Address:	172.16.202.7																																																																																																																																																																																																																																																																																	
		Type:	SMF VLAN STACKED EDGE SW WITH 4SFP				Power Source:	UPS1																																																																																																																																																																																																																																																																																	
		VLAN	MEDIA	ID#	PORT	DEVICE	DEVICE DESCRIPTION	IP ADDRESS																																																																																																																																																																																																																																																																																	
		PDH	CAT6	-	1	SPARE	-	-																																																																																																																																																																																																																																																																																	
		PDH	CAT6	-	2	SPARE	-	-																																																																																																																																																																																																																																																																																	
		PDH	CAT6	-	3	SPARE	-	-																																																																																																																																																																																																																																																																																	
		PDH	CAT6	-	4	SPARE	-	-																																																																																																																																																																																																																																																																																	
PDH	CAT6	-	5	SPARE	-	-																																																																																																																																																																																																																																																																																			
PDH	CAT6	-	6	SPARE	-	-																																																																																																																																																																																																																																																																																			
PDH	CAT6	-	7	SPARE	-	-																																																																																																																																																																																																																																																																																			
PDH	CAT6	-	8	SPARE	-	-																																																																																																																																																																																																																																																																																			
PDH	CAT6	-	9	SPARE	-	-																																																																																																																																																																																																																																																																																			
PDH	CAT6	-	10	SPARE	-	-																																																																																																																																																																																																																																																																																			
UDH	CAT6	-	11	SPARE	-	-																																																																																																																																																																																																																																																																																			
UDH	CAT6	-	12	SPARE	-	-																																																																																																																																																																																																																																																																																			
UDH	CAT6	-	13	SPARE	-	-																																																																																																																																																																																																																																																																																			
UDH	CAT6	-	14	SPARE	-	-																																																																																																																																																																																																																																																																																			
UDH	CAT6	7	14	E1:KEYPAD	E1 - KEYPAD	172.16.101.119																																																																																																																																																																																																																																																																																			
UDH	CAT6	7	15	E1:M1	E1 - M1 - CONTROLLER	172.16.101.116																																																																																																																																																																																																																																																																																			
UDH	CAT6	-	16	SPARE	-	-																																																																																																																																																																																																																																																																																			
UDH	CAT6	7	17	L1	GT1 STATIC STARTER – LS2100e	172.16.101.110																																																																																																																																																																																																																																																																																			
UDH	CAT6	-	18	SPARE	-	-																																																																																																																																																																																																																																																																																			
UDH	CAT6	-	19	SPARE	-	-																																																																																																																																																																																																																																																																																			
UDH	CAT6	-	20	SPARE	-	-																																																																																																																																																																																																																																																																																			
UDH	CAT6	-	21	SPARE	-	-																																																																																																																																																																																																																																																																																			
UDH	CAT6	-	22	SPARE	-	-																																																																																																																																																																																																																																																																																			
MDH	CAT6	-	23	SPARE	-	-																																																																																																																																																																																																																																																																																			
MDH	CAT6	-	24	SPARE	-	172.16.16.1																																																																																																																																																																																																																																																																																			
Trunk	SMF	37	G1	RB1-1:7	SMF VLAN STACKED ROOT BRIDGE SW (CCR)	172.16.205.247																																																																																																																																																																																																																																																																																			
Trunk	SMF	-	G2	SPARE	-	-																																																																																																																																																																																																																																																																																			
Trunk	SMF	-	G3	SPARE	-	-																																																																																																																																																																																																																																																																																			
Trunk	SMF	-	G4	SPARE	-	-																																																																																																																																																																																																																																																																																			
STACK	STACKING	30	STACKING 1	SW7-2: STACKING 2	9200L EDGE SWITCH	-																																																																																																																																																																																																																																																																																			
STACK	STACKING	30	STACKING 2	SW7-2: STACKING 1	9200L EDGE SWITCH	-																																																																																																																																																																																																																																																																																			
D		<table><thead><tr><th colspan="7">B</th></tr><tr><td>Switch:</td><td colspan="2">SW7-2 (11CSA07GH002)</td><td>ID#:</td><td colspan="2">33</td><td>Location:</td><td colspan="4">LEC BUILDING – NETWORK RACK</td></tr><tr><td>Part No:</td><td colspan="4">117T6409P36RCAAB</td><td>IP Address:</td><td colspan="4">172.16.202.7</td></tr><tr><td>Type:</td><td colspan="4">SMF VLAN STACKED EDGE SW WITH 4SFP</td><td>Power Source:</td><td colspan="4">UPS2</td></tr><tr><th>VLAN</th><th>MEDIA</th><th>ID#</th><th>PORT</th><th>DEVICE</th><th>DEVICE DESCRIPTION</th><th>IP ADDRESS</th></tr></thead><tbody><tr><td>PDH</td><td>CAT6</td><td>-</td><td>1</td><td>SPARE</td><td>-</td><td>-</td></tr><tr><td>PDH</td><td>CAT6</td><td>-</td><td>2</td><td>SPARE</td><td>-</td><td>-</td></tr><tr><td>PDH</td><td>CAT6</td><td>-</td><td>3</td><td>SPARE</td><td>-</td><td>-</td></tr><tr><td>PDH</td><td>CAT6</td><td>-</td><td>4</td><td>SPARE</td><td>-</td><td>-</td></tr><tr><td>PDH</td><td>CAT6</td><td>-</td><td>5</td><td>SPARE</td><td>-</td><td>-</td></tr><tr><td>PDH</td><td>CAT6</td><td>-</td><td>6</td><td>SPARE</td><td>-</td><td>-</td></tr><tr><td>PDH</td><td>CAT6</td><td>-</td><td>7</td><td>SPARE</td><td>-</td><td>-</td></tr><tr><td>PDH</td><td>CAT6</td><td>-</td><td>8</td><td>SPARE</td><td>-</td><td>-</td></tr><tr><td>PDH</td><td>CAT6</td><td>-</td><td>9</td><td>SPARE</td><td>-</td><td>-</td></tr><tr><td>PDH</td><td>CAT6</td><td>-</td><td>10</td><td>SPARE</td><td>-</td><td>-</td></tr><tr><td>UDH</td><td>CAT6</td><td>-</td><td>11</td><td>SPARE</td><td>-</td><td>-</td></tr><tr><td>UDH</td><td>CAT6</td><td>-</td><td>12</td><td>SPARE</td><td>-</td><td>-</td></tr><tr><td>UDH</td><td>CAT6</td><td>-</td><td>13</td><td>SPARE</td><td>-</td><td>-</td></tr><tr><td>UDH</td><td>CAT6</td><td>-</td><td>14</td><td>SPARE</td>d>23</td><td>SPARE</td><td>-</td><td>-</td></tr><tr><td>MDH</td><td>CAT6</td><td>-</td><td>24</td><td>SPARE</td><td>-</td><td>-</td></tr><tr><td>Trunk</td><td>SMF</td><td>37</td><td>G1</td><td>RB1-2:7</td><td>SMF VLAN STACKED ROOT BRIDGE SW (CCR)</td><td>172.16.205.247</td></tr><tr><td>Trunk</td><td>SMF</td><td>-</td><td>G2</td><td>SPARE</td><td>-</td><td>-</td></tr><tr><td>Trunk</td><td>SMF</td><td>-</td><td>G3</td><td>SPARE</td><td>-</td><td>-</td></tr><tr><td>Trunk</td><td>SMF</td><td>-</td><td>G4</td><td>SPARE</td><td>-</td><td>-</td></tr><tr><td>STACK</td><td>STACKING</td><td>30</td><td>STACKING 1</td><td>SW7-1: STACKING 2</td><td>9200L EDGE SWITCH</td><td>-</td></tr><tr><td>STACK</td><td>STACKING</td><td>30</td><td>STACKING 2</td><td>SW7-1: STACKING 1</td><td>9200L EDGE SWITCH</td><td>-</td></tr></tbody></table>																B							Switch:	SW7-2 (11CSA07GH002)		ID#:	33		Location:	LEC BUILDING – NETWORK RACK				Part No:	117T6409P36RCAAB				IP Address:	172.16.202.7				Type:	SMF VLAN STACKED EDGE SW WITH 4SFP				Power Source:	UPS2				VLAN	MEDIA	ID#	PORT	DEVICE	DEVICE DESCRIPTION	IP ADDRESS	PDH	CAT6	-	1	SPARE	-	-	PDH	CAT6	-	2	SPARE	-	-	PDH	CAT6	-	3	SPARE	-	-	PDH	CAT6	-	4	SPARE	-	-	PDH	CAT6	-	5	SPARE	-	-	PDH	CAT6	-	6	SPARE	-	-	PDH	CAT6	-	7	SPARE	-	-	PDH	CAT6	-	8	SPARE	-	-	PDH	CAT6	-	9	SPARE	-	-	PDH	CAT6	-	10	SPARE	-	-	UDH	CAT6	-	11	SPARE	-	-	UDH	CAT6	-	12	SPARE	-	-	UDH	CAT6	-	13	SPARE	-	-	UDH	CAT6	-	14	SPARE	-	-	UDH	CAT6	7	15	E1:M2	E1 – M2 - CONTROLLER	172.16.101.117	UDH	CAT6	7	16	E1:C	E1 - C - CONTROLLER	172.16.101.118	UDH	CAT6	-	17	SPARE	-	-	UDH	CAT6	-	18	SPARE	-	-	UDH	CAT6	-	19	SPARE	-	-	UDH	CAT6	-	20	SPARE	-	-	UDH	CAT6	-	21	SPARE	-	-	UDH	CAT6	-	22	SPARE	-	-	MDH	CAT6	-	23	SPARE	-	-	MDH	CAT6	-	24	SPARE	-	-	Trunk	SMF	37	G1	RB1-2:7	SMF VLAN STACKED ROOT BRIDGE SW (CCR)	172.16.205.247	Trunk	SMF	-	G2	SPARE	-	-	Trunk	SMF	-	G3	SPARE	-	-	Trunk	SMF	-	G4	SPARE	-	-	STACK	STACKING	30	STACKING 1	SW7-1: STACKING 2	9200L EDGE SWITCH	-	STACK	STACKING	30	STACKING 2	SW7-1: STACKING 1	9200L EDGE SWITCH	-	D								
		B																																																																																																																																																																																																																																																																																							
		Switch:	SW7-2 (11CSA07GH002)		ID#:	33		Location:	LEC BUILDING – NETWORK RACK																																																																																																																																																																																																																																																																																
		Part No:	117T6409P36RCAAB				IP Address:	172.16.202.7																																																																																																																																																																																																																																																																																	
		Type:	SMF VLAN STACKED EDGE SW WITH 4SFP				Power Source:	UPS2																																																																																																																																																																																																																																																																																	
		VLAN	MEDIA	ID#	PORT	DEVICE	DEVICE DESCRIPTION	IP ADDRESS																																																																																																																																																																																																																																																																																	
		PDH	CAT6	-	1	SPARE	-	-																																																																																																																																																																																																																																																																																	
		PDH	CAT6	-	2	SPARE	-	-																																																																																																																																																																																																																																																																																	
		PDH	CAT6	-	3	SPARE	-	-																																																																																																																																																																																																																																																																																	
		PDH	CAT6	-	4	SPARE	-	-																																																																																																																																																																																																																																																																																	
PDH	CAT6	-	5	SPARE	-	-																																																																																																																																																																																																																																																																																			
PDH	CAT6	-	6	SPARE	-	-																																																																																																																																																																																																																																																																																			
PDH	CAT6	-	7	SPARE	-	-																																																																																																																																																																																																																																																																																			
PDH	CAT6	-	8	SPARE	-	-																																																																																																																																																																																																																																																																																			
PDH	CAT6	-	9	SPARE	-	-																																																																																																																																																																																																																																																																																			
PDH	CAT6	-	10	SPARE	-	-																																																																																																																																																																																																																																																																																			
UDH	CAT6	-	11	SPARE	-	-																																																																																																																																																																																																																																																																																			
UDH	CAT6	-	12	SPARE	-	-																																																																																																																																																																																																																																																																																			
UDH	CAT6	-	13	SPARE	-	-																																																																																																																																																																																																																																																																																			
UDH	CAT6	-	14	SPARE	-	-																																																																																																																																																																																																																																																																																			
UDH	CAT6	7	15	E1:M2	E1 – M2 - CONTROLLER	172.16.101.117																																																																																																																																																																																																																																																																																			
UDH	CAT6	7	16	E1:C	E1 - C - CONTROLLER	172.16.101.118																																																																																																																																																																																																																																																																																			
UDH	CAT6	-	17	SPARE	-	-																																																																																																																																																																																																																																																																																			
UDH	CAT6	-	18	SPARE	-	-																																																																																																																																																																																																																																																																																			
UDH	CAT6	-	19	SPARE	-	-																																																																																																																																																																																																																																																																																			
UDH	CAT6	-	20	SPARE	-	-																																																																																																																																																																																																																																																																																			
UDH	CAT6	-	21	SPARE	-	-																																																																																																																																																																																																																																																																																			
UDH	CAT6	-	22	SPARE	-	-																																																																																																																																																																																																																																																																																			
MDH	CAT6	-	23	SPARE	-	-																																																																																																																																																																																																																																																																																			
MDH	CAT6	-	24	SPARE	-	-																																																																																																																																																																																																																																																																																			
Trunk	SMF	37	G1	RB1-2:7	SMF VLAN STACKED ROOT BRIDGE SW (CCR)	172.16.205.247																																																																																																																																																																																																																																																																																			
Trunk	SMF	-	G2	SPARE	-	-																																																																																																																																																																																																																																																																																			
Trunk	SMF	-	G3	SPARE	-	-																																																																																																																																																																																																																																																																																			
Trunk	SMF	-	G4	SPARE	-	-																																																																																																																																																																																																																																																																																			
STACK	STACKING	30	STACKING 1	SW7-1: STACKING 2	9200L EDGE SWITCH	-																																																																																																																																																																																																																																																																																			
STACK	STACKING	30	STACKING 2	SW7-1: STACKING 1	9200L EDGE SWITCH	-																																																																																																																																																																																																																																																																																			
E																		E																																																																																																																																																																																																																																																																							
F		LEC BUILDING NLR Copyright © GE Vernova and/or its affiliates 2021-2025 All rights reserved. The information herein is proprietary information of GE Vernova and/ or its affiliates.																F																																																																																																																																																																																																																																																																							
		1		2		3		4		5		6		7		8																																																																																																																																																																																																																																																																									



GE VERNOVA

Document Type: TECHNICAL DOCUMENT		Sheet Size: B	
Document Title: ASSY, REMOTE CONTROL SYS			
Drawing Number: 302T0147		Revision: E	Sheet: 12 of 27

		1		2		3		4		5		6		7		8																																																																																																																																																																																																																																																							
A		FEED WATER BUILDING (11CJY01) HRSG1S MARK VIeS R S T																A																																																																																																																																																																																																																																																					
B		UDH PDH MDH																B																																																																																																																																																																																																																																																					
C		<table><tr><th colspan="7">A</th></tr><tr><td>Switch:</td><td>SWP1</td><td>ID#:</td><td>42</td><td>Location:</td><td colspan="3">FEED WATER BUILDING</td></tr><tr><td>Part No:</td><td colspan="3">117T6409P041ACAD</td><td>IP Address:</td><td colspan="3">172.16.203.1</td></tr><tr><td>Type:</td><td colspan="3">SMF VLAN CISCO IE 1SFP SW (8 PORT)</td><td>Power Source:</td><td colspan="3">ST1 TCP PANEL</td></tr><tr><th>VLAN</th><th>MEDIA</th><th>ID#</th><th>PORT</th><th>DEVICE</th><th>DEVICE DESCRIPTION</th><th>IP ADDRESS</th></tr><tr><td>PDH</td><td>CAT6</td><td>-</td><td>1X</td><td>SPARE</td><td>-</td><td>-</td></tr><tr><td>PDH</td><td>CAT6</td><td>-</td><td>2X</td><td>SPARE</td><td>-</td><td>-</td></tr><tr><td>UDH</td><td>CAT6</td><td></td><td>3X</td><td>SPARE</td><td>-</td><td>-</td></tr><tr><td>UDH</td><td>CAT6</td><td></td><td>4X</td><td>SPARE</td><td>-</td><td>-</td></tr><tr><td>UDH</td><td>CAT6</td><td>5</td><td>5X</td><td>HRSG1S:R</td><td>HRSG1S <R> CONTROLLER</td><td>172.16.101.138</td></tr><tr><td>UDH</td><td>CAT6</td><td>-</td><td>6X</td><td>SPARE</td><td>-</td><td>-</td></tr><tr><td>UDH</td><td>CAT6</td><td>-</td><td>7X</td><td>SPARE</td><td>-</td><td>-</td></tr><tr><td>UDH</td><td>CAT6</td><td>-</td><td>8X</td><td>SPARE</td><td>-</td><td>-</td></tr><tr><td>Trunk</td><td>SMF</td><td>1,3</td><td>Port 1</td><td>RB1-1:8</td><td>SMF VLAN STACKED ROOT BRIDGE SW (HRSGS)</td><td>172.16.205.247</td></tr><tr><td>Trunk</td><td>SMF</td><td>-</td><td>Port 2</td><td>NA</td><td>DO NOT USE</td><td>-</td></tr><tr><td>Trunk</td><td>CAT6</td><td>-</td><td>Port 1</td><td>NA</td><td>DO NOT USE</td><td>-</td></tr><tr><td>Trunk</td><td>CAT6</td><td>7</td><td>Port 2</td><td>SWP2:PORT 2</td><td>SMF VLAN CISCO IE 1SFP SW (8 PORT)</td><td>172.16.203.2</td></tr></table> <table><tr><th colspan="7"></th></tr><tr><td>Switch:</td><td>SWP2</td><td>ID#:</td><td>42</td><td>Location:</td><td colspan="3">FEED WATER BUILDING</td></tr><tr><td>Part No:</td><td colspan="3">117T6409P041ACAD</td><td>IP Address:</td><td colspan="3">172.16.203.2</td></tr><tr><td>Type:</td><td colspan="3">SMF VLAN CISCO IE 1SFP SW (8 PORT)</td><td>Power Source:</td><td colspan="3">ST1 TCP PANEL</td></tr><tr><th>VLAN</th><th>MEDIA</th><th>ID#</th><th>PORT</th><th>DEVICE</th><th>DEVICE DESCRIPTION</th><th>IP ADDRESS</th></tr><tr><td>PDH</td><td>CAT6</td><td>-</td><td>1X</td><td>SPARE</td><td>-</td><td>-</td></tr><tr><td>PDH</td><td>CAT6</td><td>-</td><td>2X</td><td>SPARE</td><td>-</td><td>-</td></tr><tr><td>UDH</td><td>CAT6</td><td>-</td><td>3X</td><td>SPARE</td><td>-</td><td>-</td></tr><tr><td>UDH</td><td>CAT6</td><td>-</td><td>4X</td><td>SPARE</td><td>-</td><td>-</td></tr><tr><td>UDH</td><td>CAT6</td><td>5</td><td>5X</td><td>HRSG1S:S</td><td>HRSG1S <S> CONTROLLER</td><td>172.16.101.139</td></tr><tr><td>UDH</td><td>CAT6</td><td>5</td><td>6X</td><td>HRSG1S:T</td><td>HRSG1S <T> CONTROLLER</td><td>172.16.101.140</td></tr><tr><td>UDH</td><td>CAT6</td><td>-</td><td>7X</td><td>SPARE</td><td>-</td><td>-</td></tr><tr><td>UDH</td><td>CAT6</td><td>-</td><td>8X</td><td>SPARE</td><td>-</td><td>-</td></tr><tr><td>Trunk</td><td>SMF</td><td>1,3</td><td>Port 1</td><td>RB1-2:8</td><td>SMF VLAN STACKED ROOT BRIDGE SW (HRSGS)</td><td>172.16.205.247</td></tr><tr><td>Trunk</td><td>SMF</td><td>-</td><td>Port 2</td><td>NA</td><td>DO NOT USE</td><td>-</td></tr><tr><td>Trunk</td><td>CAT6</td><td>-</td><td>Port 1</td><td>NA</td><td>DO NOT USE</td><td>-</td></tr><tr><td>Trunk</td><td>CAT6</td><td>7</td><td>Port 2</td><td>SWP1:PORT 2</td><td>SMF VLAN CISCO IE 1SFP SW (8 PORT)</td><td>172.16.203.1</td></tr></table>																A							Switch:	SWP1	ID#:	42	Location:	FEED WATER BUILDING			Part No:	117T6409P041ACAD			IP Address:	172.16.203.1			Type:	SMF VLAN CISCO IE 1SFP SW (8 PORT)			Power Source:	ST1 TCP PANEL			VLAN	MEDIA	ID#	PORT	DEVICE	DEVICE DESCRIPTION	IP ADDRESS	PDH	CAT6	-	1X	SPARE	-	-	PDH	CAT6	-	2X	SPARE	-	-	UDH	CAT6		3X	SPARE	-	-	UDH	CAT6		4X	SPARE	-	-	UDH	CAT6	5	5X	HRSG1S:R	HRSG1S <R> CONTROLLER	172.16.101.138	UDH	CAT6	-	6X	SPARE	-	-	UDH	CAT6	-	7X	SPARE	-	-	UDH	CAT6	-	8X	SPARE	-	-	Trunk	SMF	1,3	Port 1	RB1-1:8	SMF VLAN STACKED ROOT BRIDGE SW (HRSGS)	172.16.205.247	Trunk	SMF	-	Port 2	NA	DO NOT USE	-	Trunk	CAT6	-	Port 1	NA	DO NOT USE	-	Trunk	CAT6	7	Port 2	SWP2:PORT 2	SMF VLAN CISCO IE 1SFP SW (8 PORT)	172.16.203.2								Switch:	SWP2	ID#:	42	Location:	FEED WATER BUILDING			Part No:	117T6409P041ACAD			IP Address:	172.16.203.2			Type:	SMF VLAN CISCO IE 1SFP SW (8 PORT)			Power Source:	ST1 TCP PANEL			VLAN	MEDIA	ID#	PORT	DEVICE	DEVICE DESCRIPTION	IP ADDRESS	PDH	CAT6	-	1X	SPARE	-	-	PDH	CAT6	-	2X	SPARE	-	-	UDH	CAT6	-	3X	SPARE	-	-	UDH	CAT6	-	4X	SPARE	-	-	UDH	CAT6	5	5X	HRSG1S:S	HRSG1S <S> CONTROLLER	172.16.101.139	UDH	CAT6	5	6X	HRSG1S:T	HRSG1S <T> CONTROLLER	172.16.101.140	UDH	CAT6	-	7X	SPARE	-	-	UDH	CAT6	-	8X	SPARE	-	-	Trunk	SMF	1,3	Port 1	RB1-2:8	SMF VLAN STACKED ROOT BRIDGE SW (HRSGS)	172.16.205.247	Trunk	SMF	-	Port 2	NA	DO NOT USE	-	Trunk	CAT6	-	Port 1	NA	DO NOT USE	-	Trunk	CAT6	7	Port 2	SWP1:PORT 2	SMF VLAN CISCO IE 1SFP SW (8 PORT)	172.16.203.1	C	
A																																																																																																																																																																																																																																																																							
Switch:	SWP1	ID#:	42	Location:	FEED WATER BUILDING																																																																																																																																																																																																																																																																		
Part No:	117T6409P041ACAD			IP Address:	172.16.203.1																																																																																																																																																																																																																																																																		
Type:	SMF VLAN CISCO IE 1SFP SW (8 PORT)			Power Source:	ST1 TCP PANEL																																																																																																																																																																																																																																																																		
VLAN	MEDIA	ID#	PORT	DEVICE	DEVICE DESCRIPTION	IP ADDRESS																																																																																																																																																																																																																																																																	
PDH	CAT6	-	1X	SPARE	-	-																																																																																																																																																																																																																																																																	
PDH	CAT6	-	2X	SPARE	-	-																																																																																																																																																																																																																																																																	
UDH	CAT6		3X	SPARE	-	-																																																																																																																																																																																																																																																																	
UDH	CAT6		4X	SPARE	-	-																																																																																																																																																																																																																																																																	
UDH	CAT6	5	5X	HRSG1S:R	HRSG1S <R> CONTROLLER	172.16.101.138																																																																																																																																																																																																																																																																	
UDH	CAT6	-	6X	SPARE	-	-																																																																																																																																																																																																																																																																	
UDH	CAT6	-	7X	SPARE	-	-																																																																																																																																																																																																																																																																	
UDH	CAT6	-	8X	SPARE	-	-																																																																																																																																																																																																																																																																	
Trunk	SMF	1,3	Port 1	RB1-1:8	SMF VLAN STACKED ROOT BRIDGE SW (HRSGS)	172.16.205.247																																																																																																																																																																																																																																																																	
Trunk	SMF	-	Port 2	NA	DO NOT USE	-																																																																																																																																																																																																																																																																	
Trunk	CAT6	-	Port 1	NA	DO NOT USE	-																																																																																																																																																																																																																																																																	
Trunk	CAT6	7	Port 2	SWP2:PORT 2	SMF VLAN CISCO IE 1SFP SW (8 PORT)	172.16.203.2																																																																																																																																																																																																																																																																	
Switch:	SWP2	ID#:	42	Location:	FEED WATER BUILDING																																																																																																																																																																																																																																																																		
Part No:	117T6409P041ACAD			IP Address:	172.16.203.2																																																																																																																																																																																																																																																																		
Type:	SMF VLAN CISCO IE 1SFP SW (8 PORT)			Power Source:	ST1 TCP PANEL																																																																																																																																																																																																																																																																		
VLAN	MEDIA	ID#	PORT	DEVICE	DEVICE DESCRIPTION	IP ADDRESS																																																																																																																																																																																																																																																																	
PDH	CAT6	-	1X	SPARE	-	-																																																																																																																																																																																																																																																																	
PDH	CAT6	-	2X	SPARE	-	-																																																																																																																																																																																																																																																																	
UDH	CAT6	-	3X	SPARE	-	-																																																																																																																																																																																																																																																																	
UDH	CAT6	-	4X	SPARE	-	-																																																																																																																																																																																																																																																																	
UDH	CAT6	5	5X	HRSG1S:S	HRSG1S <S> CONTROLLER	172.16.101.139																																																																																																																																																																																																																																																																	
UDH	CAT6	5	6X	HRSG1S:T	HRSG1S <T> CONTROLLER	172.16.101.140																																																																																																																																																																																																																																																																	
UDH	CAT6	-	7X	SPARE	-	-																																																																																																																																																																																																																																																																	
UDH	CAT6	-	8X	SPARE	-	-																																																																																																																																																																																																																																																																	
Trunk	SMF	1,3	Port 1	RB1-2:8	SMF VLAN STACKED ROOT BRIDGE SW (HRSGS)	172.16.205.247																																																																																																																																																																																																																																																																	
Trunk	SMF	-	Port 2	NA	DO NOT USE	-																																																																																																																																																																																																																																																																	
Trunk	CAT6	-	Port 1	NA	DO NOT USE	-																																																																																																																																																																																																																																																																	
Trunk	CAT6	7	Port 2	SWP1:PORT 2	SMF VLAN CISCO IE 1SFP SW (8 PORT)	172.16.203.1																																																																																																																																																																																																																																																																	
D																		D																																																																																																																																																																																																																																																					
E																		E																																																																																																																																																																																																																																																					
F		FEED WATER BUILDING NLR Copyright © GE Vernova and/or its affiliates 2021-2025 All rights reserved. The information herein is proprietary information of GE Vernova and/or its affiliates. GE VERNOVA Document Type: TECHNICAL DOCUMENT Document Title: ASSY, REMOTE CONTROL SYS Creation Date: 2021-10-28 Sheet Size: B Revision: E Sheet: 14 of 27 Drawing Number: 302T0147																F																																																																																																																																																																																																																																																					
		1		2		3		4		5		6		7		8																																																																																																																																																																																																																																																							

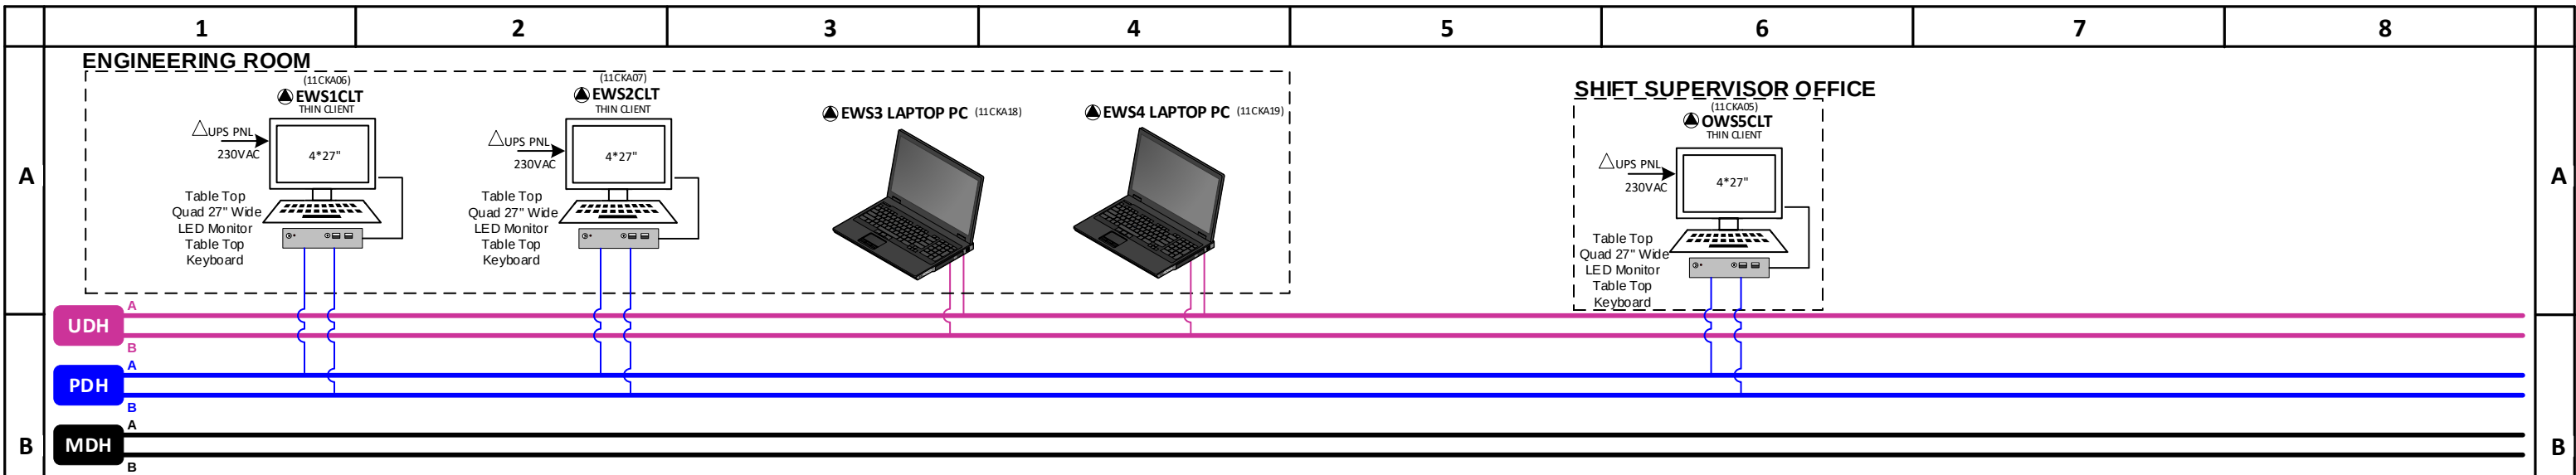

C

D

E

A						
Switch:	SW3-1 (11CSA02GH005)			ID#:	33	
Part No:	117T6409P36RCAAB				IP Address:	172.16.202.3
Type:	SMF VLAN STACKED EDGE SW WITH 4SFP				Power Source:	UPS1
VLAN	MEDIA	ID#	PORT	DEVICE	DEVICE DESCRIPTION	IP ADDRESS
PDH	CAT6	6	1	EWS1CLT:1	THIN CLIENT - PRIMARY	172.16.200.3
PDH	CAT6	6	2	EWS2CLT:1	THIN CLIENT - PRIMARY	172.16.200.4
PDH	CAT6	6	3	OWS5CLT:1	THIN CLIENT - PRIMARY	172.16.200.9
PDH	CAT6	6	4	EWS3	ENGINEERING LAPTOP EWS3 - PRIMARY	172.16.205.122
PDH	CAT6	6	5	EWS4	ENGINEERING LAPTOP EWS4 - PRIMARY	172.16.205.123
PDH	CAT6	-	6	SPARE	-	-
PDH	CAT6	-	7	SPARE	-	-
PDH	CAT6	-	8	SPARE	-	-
PDH	CAT6	-	9	SPARE	-	-
PDH	CAT6	-	10	SPARE	-	-
UDH	CAT6	6	11	EWS3	ENGINEERING LAPTOP EWS3 - PRIMARY	172.16.101.22
UDH	CAT6	6	12	EWS4	ENGINEERING LAPTOP EWS4 - PRIMARY	172.16.101.23
UDH	CAT6	-	13	SPARE	-	-
UDH	CAT6	-	14	SPARE	-	-
UDH	CAT6	-	15	SPARE	-	-
UDH	CAT6	-	16	SPARE	-	-
UDH	CAT6	-	17	SPARE	-	-
UDH	CAT6	-	18	SPARE	-	-
UDH	CAT6	-	19	SPARE	-	-
SPAN	CAT6	-	20	SPARE	-	-
UDH	CAT6	-	21	SPARE	-	-
UDH	CAT6	-	22	SPARE	-	-
MDH	CAT6	-	23	SPARE	-	-
MDH	CAT6	-	24	SPARE	-	-
Trunk	SMF	37	G1	RB1-1:3	SMF VLAN STACKED ROOT BRIDGE SW (CCR)	172.16.205.247
Trunk	SMF	-	G2	SPARE	-	-
Trunk	SMF	-	G3	SPARE	-	-
Trunk	SMF	-	G4	SPARE	-	-
STACK	STACKING	30	STACKING 1	SW3-2: STACKING 2	9200L EDGE SWITCH	-
STACK	STACKING	30	STACKING 2	SW3-2: STACKING 1	9200L EDGE SWITCH	-

B

Switch:	SW3-2 (11CSA02GH006)			ID#:	33	
Part No:	117T6409P36RCAAB				IP Address:	172.16.202.3
Type:	SMF VLAN STACKED EDGE SW WITH 4SFP				Power Source:	UPS2
VLAN	MEDIA	ID#	PORT	DEVICE	DEVICE DESCRIPTION	IP ADDRESS
PDH	CAT6	6	1	EWS1CLT:2	THIN CLIENT - SECONDARY	172.16.200.3
PDH	CAT6	6	2	EWS2CLT:2	THIN CLIENT - SECONDARY	172.16.200.4
PDH	CAT6	6	3	OWS5CLT:2	THIN CLIENT - SECONDARY	172.16.200.9
PDH	CAT6	6	4	EWS3	ENGINEERING LAPTOP EWS3 - SECONDARY	172.16.205.122
PDH	CAT6	6	5	EWS4	ENGINEERING LAPTOP EWS4 - SECONDARY	172.16.205.123
PDH	CAT6	-	6	SPARE	-	-
PDH	CAT6	-	7	SPARE	-	-
PDH	CAT6	-	8	SPARE	-	-
PDH	CAT6	-	9	SPARE	-	-
PDH	CAT6	-	10	SPARE	-	-
UDH	CAT6	6	11	EWS3	ENGINEERING LAPTOP EWS3 - SECONDARY	172.16.101.22
UDH	CAT6	6	12	EWS4	ENGINEERING LAPTOP EWS4 - SECONDARY	172.16.101.23
UDH	CAT6	-	13	SPARE	-	-
UDH	CAT6	-	14	SPARE	-	-
UDH	CAT6	-	15	SPARE	-	-
UDH	CAT6	-	16	SPARE	-	-
UDH	CAT6	-	17	SPARE	-	-
UDH	CAT6	-	18	SPARE	-	-
UDH	CAT6	-	19	SPARE	-	-
SPAN	CAT6	-	20	SPARE	-	-
UDH	CAT6	-	21	SPARE	-	-
UDH	CAT6	-	22	SPARE	-	-
MDH	CAT6	-	23	SPARE	-	-
MDH	CAT6	-	24	SPARE	-	-
Trunk	SMF	37	G1	RB1-2:3	SMF VLAN STACKED ROOT BRIDGE SW (CCR)	172.16.205.247
Trunk	SMF	-	G2	SPARE	-	-
Trunk	SMF	-	G3	SPARE	-	-
Trunk	SMF	-	G4	SPARE	-	-
STACK	STACKING	30	STACKING 1	SW3-1: STACKING 2	9200L EDGE SWITCH	-
STACK	STACKING	30	STACKING 2	SW3-1: STACKING 1	9200L EDGE SWITCH	-

C

D

E

F	ENGINEERING ROOM	NLR Copyright © GE Vernova and/or its affiliates 2021-2025 All rights reserved. The information herein is proprietary information of GE Vernova and/or its affiliates.	 GE VERNOVA	Document Type:	Sheet Size:	
				TECHNICAL DOCUMENT	B	
				Document Title:		
				ASSY, REMOTE CONTROL SYS		
			Creation Date:	Drawing Number:	Revision:	Sheet:
			2021-10-28	302T0147	E	16 of 27

ENGINEERING ROOM

(11CWQ04)
(TABLE TOP)
▲PRN4
A3 Color Laser Printer

NON UPS PNL
230VAC

(11CWQ05)
(TABLE TOP)
▲PRN5
A3 Color Laser Printer

NON UPS PNL
230VAC

(11CWQ06)
(TABLE TOP)
▲PRN6
A3 Color Laser Printer

NON UPS PNL
230VAC

(11CWQ07)
(TABLE TOP)
▲PRN7
A3 Color Laser Printer

NON UPS PNL
230VAC

(11CKA08)
STOWCLT
THIN CLIENT

UPS PNL
230VAC

Table Top
Quad 27" Wide LED
Monitor
Table Top Keyboard

UDH

PDH

MDH

Switch:

SW4-1 (11CSA02GH007)

ID#:

33

Location:

SERVER ROOM – NETWORK CABINET 2

Part No:

117T6409P36RCAAB

IP Address:

172.16.202.4

Type:

SMF VLAN STACKED EDGE SW WITH 4SFP

Power Source:

UPS1

VLAN	MEDIA	ID#	PORT	DEVICE	DEVICE DESCRIPTION	IP ADDRESS
PDH	CAT6	6	1	SPARE	-	-
PDH	CAT6	6	2	HST2SVR	HST2SVR – HISTORIAN PRIMARY	172.16.205.39
PDH	CAT6	6	3	GTWY1SVR	DATA GATEWAY 1 - PRIMARY	172.16.205.124
PDH	CAT6	6	4	GTWY2SVR	DATA GATEWAY 2 - PRIMARY	172.16.205.125
PDH	CAT6	6	5	STOWSCLT:1	THIN CLIENT - PRIMARY	172.16.200.10
PDH	CAT6	6	6	HST1SVR	HST1SVR – HISTORIAN PRIMARY	172.16.205.38
PDH	CAT6	5	7	PRN4	A3 COLOR LASER PRINTER	172.16.205.43
PDH	CAT6	6	8	SPARE	-	-
PDH	CAT6	-	9	SPARE	-	-
PDH	CAT6	5	10	PRN6	A3 COLOR LASER PRINTER	172.16.205.45
UDH	CAT6	6	11	GTWY1SVR	DATA GATEWAY 1 - PRIMARY	172.16.101.124
UDH	CAT6	6	12	GTWY2SVR	DATA GATEWAY 2 - PRIMARY	172.16.101.125
UDH	CAT6	6	13	HST2SVR	HST2SVR – HISTORIAN PRIMARY	172.16.101.21
UDH	CAT6	6	14	SPARE	-	-
UDH	CAT6	6	15	HST1SVR	HST1SVR – HISTORIAN PRIMARY	172.16.101.20
UDH	CAT6	-	16	SPARE	-	-
UDH	CAT6	-	17	SPARE	-	-
UDH	CAT6	-	18	SPARE	-	-
UDH	CAT6	-	19	SPARE	-	-
SPAN	CAT6	-	20	SPARE	-	-
UDH	CAT6	-	21	SPARE	-	-
UDH	CAT6	-	22	SPARE	-	-
MDH	CAT6	6	23	SYSTEM ONE	SYSTEM ONE	-
MDH	CAT6	-	24	SPARE	-	-
Trunk	SMF	37	G1	RB1-1:4	SMF VLAN STACKED ROOT BRIDGE SW (CCR)	172.16.205.247
Trunk	SMF	-	G2	SPARE	-	-
Trunk	SMF	-	G3	SPARE	-	-
Trunk	SMF	-	G4	SPARE	-	-
STACK	STACKING	30	STACKING 1	SW4-2: STACKING 2	9200L EDGE SWITCH	-
STACK	STACKING	30	STACKING 2	SW4-2: STACKING 1	9200L EDGE SWITCH	-

Switch:

SW4-2 (11CSA02GH008)

ID#:

33

Location:

SERVER ROOM – NETWORK CABINET 2

Part No:

117T6409P36RCAAB

IP Address:

172.16.202.4

Type:

SMF VLAN STACKED EDGE SW WITH 4SFP

Power Source:

UPS2

VLAN	MEDIA	ID#	PORT	DEVICE	DEVICE DESCRIPTION	IP ADDRESS
PDH	CAT6	6	1	SPARE	-	-
PDH	CAT6	6	2	HST2SVR	HST2SVR – HISTORIAN SECONDARY	172.16.205.39
PDH	CAT6	6	3	GTWY1SVR	DATA GATEWAY 1 - SECONDARY	172.16.205.124
PDH	CAT6	6	4	GTWY2SVR	DATA GATEWAY 2 - SECONDARY	172.16.205.125
PDH	CAT6	6	5	STOWSCLT:2	THIN CLIENT - SECONDARY	172.16.200.10
PDH	CAT6	6	6	HST1SVR	HST1SVR – HISTORIAN SECONDARY	172.16.205.38
PDH	CAT6	5	7	PRN5	A3 COLOR LASER PRINTER	172.16.205.44
PDH	CAT6	6	8	SPARE	-	-
PDH	CAT6	-	9	SPARE	-	-
PDH	CAT6	5	10	PRN7	A3 COLOR LASER PRINTER	172.16.205.46
UDH	CAT6	6	11	GTWY1SVR	DATA GATEWAY 1 - SECONDARY	172.16.101.124
UDH	CAT6	6	12	GTWY2SVR	DATA GATEWAY 2 - SECONDARY	172.16.101.125
UDH	CAT6	6	13	HST2SVR	HST2SVR – HISTORIAN SECONDARY	172.16.101.21
UDH	CAT6	6	14	SPARE	-	-
UDH	CAT6	6	15	HST1SVR	HST1SVR – HISTORIAN SECONDARY	172.16.101.20
UDH	CAT6	-	16	SPARE	-	-
UDH	CAT6	-	17	SPARE	-	-
UDH	CAT6	-	18	SPARE	-	-
UDH	CAT6	-	19	SPARE	-	-
SPAN	CAT6	-	20	SPARE	-	-
UDH	CAT6	-	21	SPARE	-	-
UDH	CAT6	-	22	SPARE	-	-
MDH	CAT6	6	23	SYSTEM ONE	SYSTEM ONE	-
MDH	CAT6	-	24	-	-	-
Trunk	SMF	37	G1	RB1-2:4	SMF VLAN STACKED ROOT BRIDGE SW (CCR)	172.16.205.247
Trunk	SMF	-	G2	SPARE	-	-
Trunk	SMF	-	G3	SPARE	-	-
Trunk	SMF	-	G4	SPARE	-	-
STACK	STACKING	30	STACKING 1	SW4-1: STACKING 2	9200L EDGE SWITCH	-
STACK	STACKING	30	STACKING 2	SW4-1: STACKING 1	9200L EDGE SWITCH	-

SERVER ROOM

NLR

Copyright © GE Vernova and/or its affiliates 2021-2025
All rights reserved. The information herein is proprietary information of GE Vernova and/or its affiliates.

GE

GE VERNOVA

Document Type:

TECHNICAL DOCUMENT

Document Title:

ASSY, REMOTE CONTROL SYS

Creation Date:

2021-10-28

Document Type:

TECHNICAL DOCUMENT

Document Title:

ASSY, REMOTE CONTROL SYS

Creation Date:

2021-10-28

Sheet Size:

B

Revision:

E

Sheet:

17 of 27

1

2

3

4

5

6

7

8

1

2

3

4

5


6


7


8

Non-Public - Class II (Non Critical)

NLR

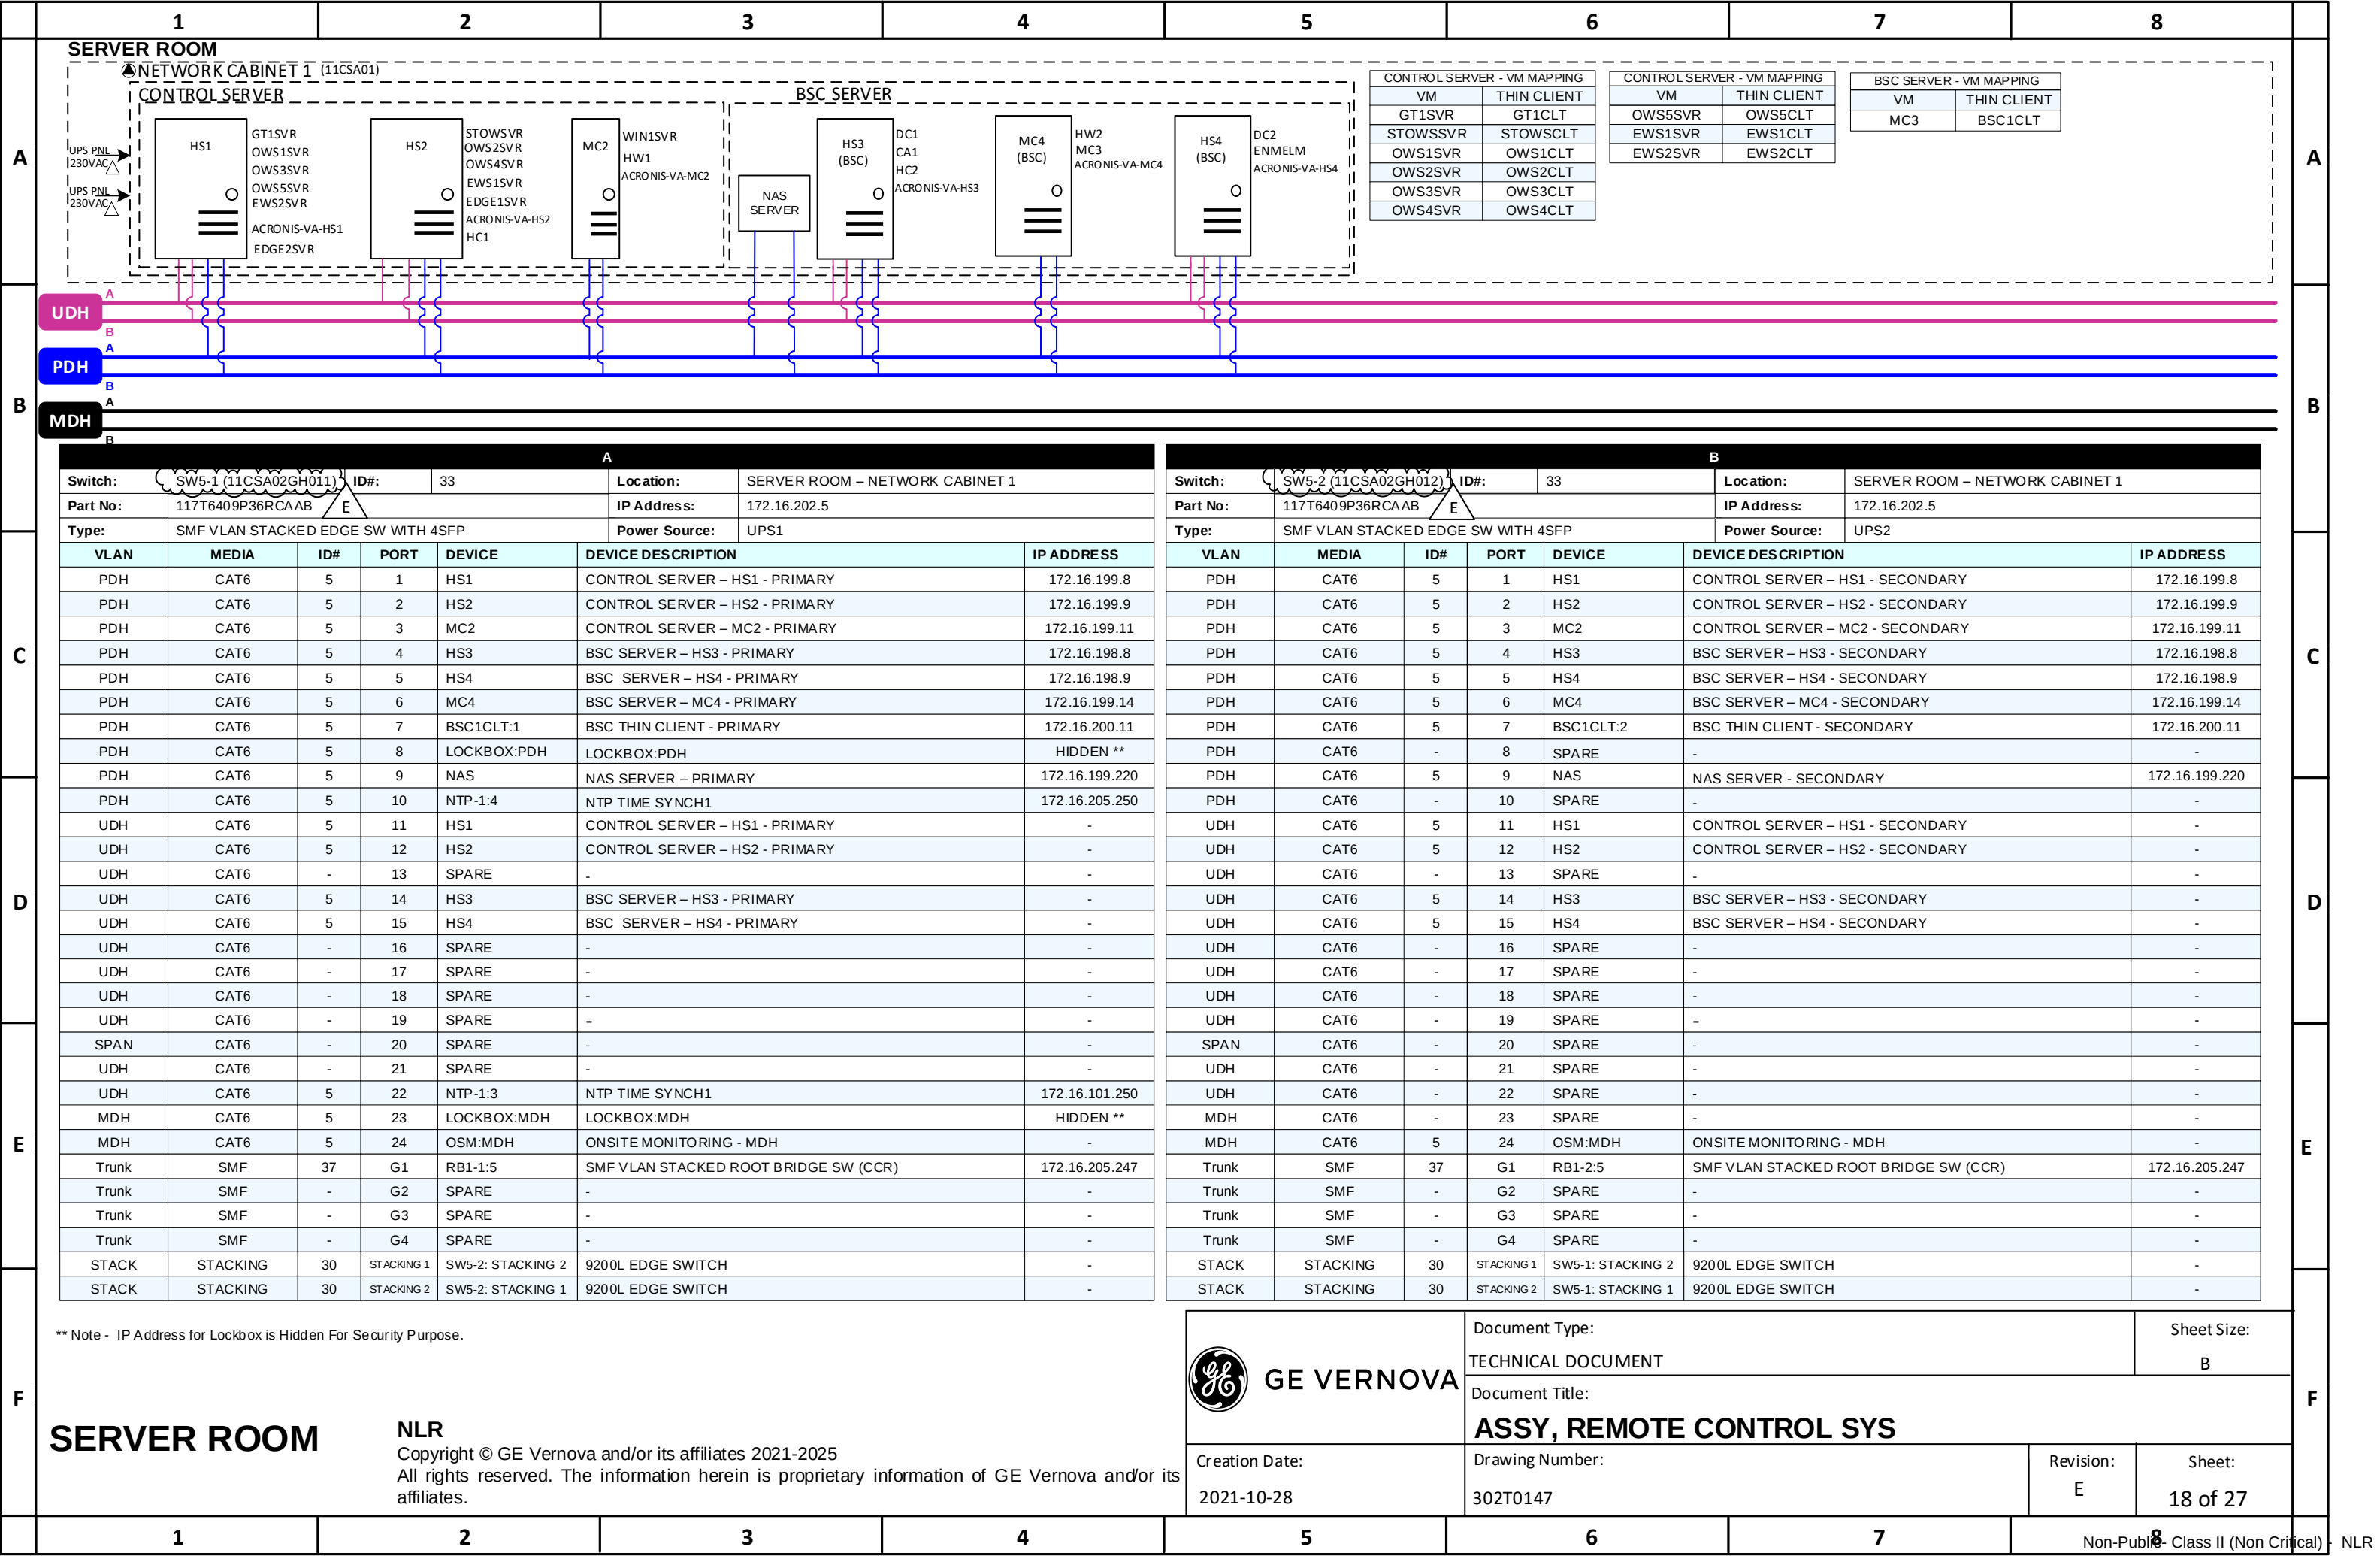


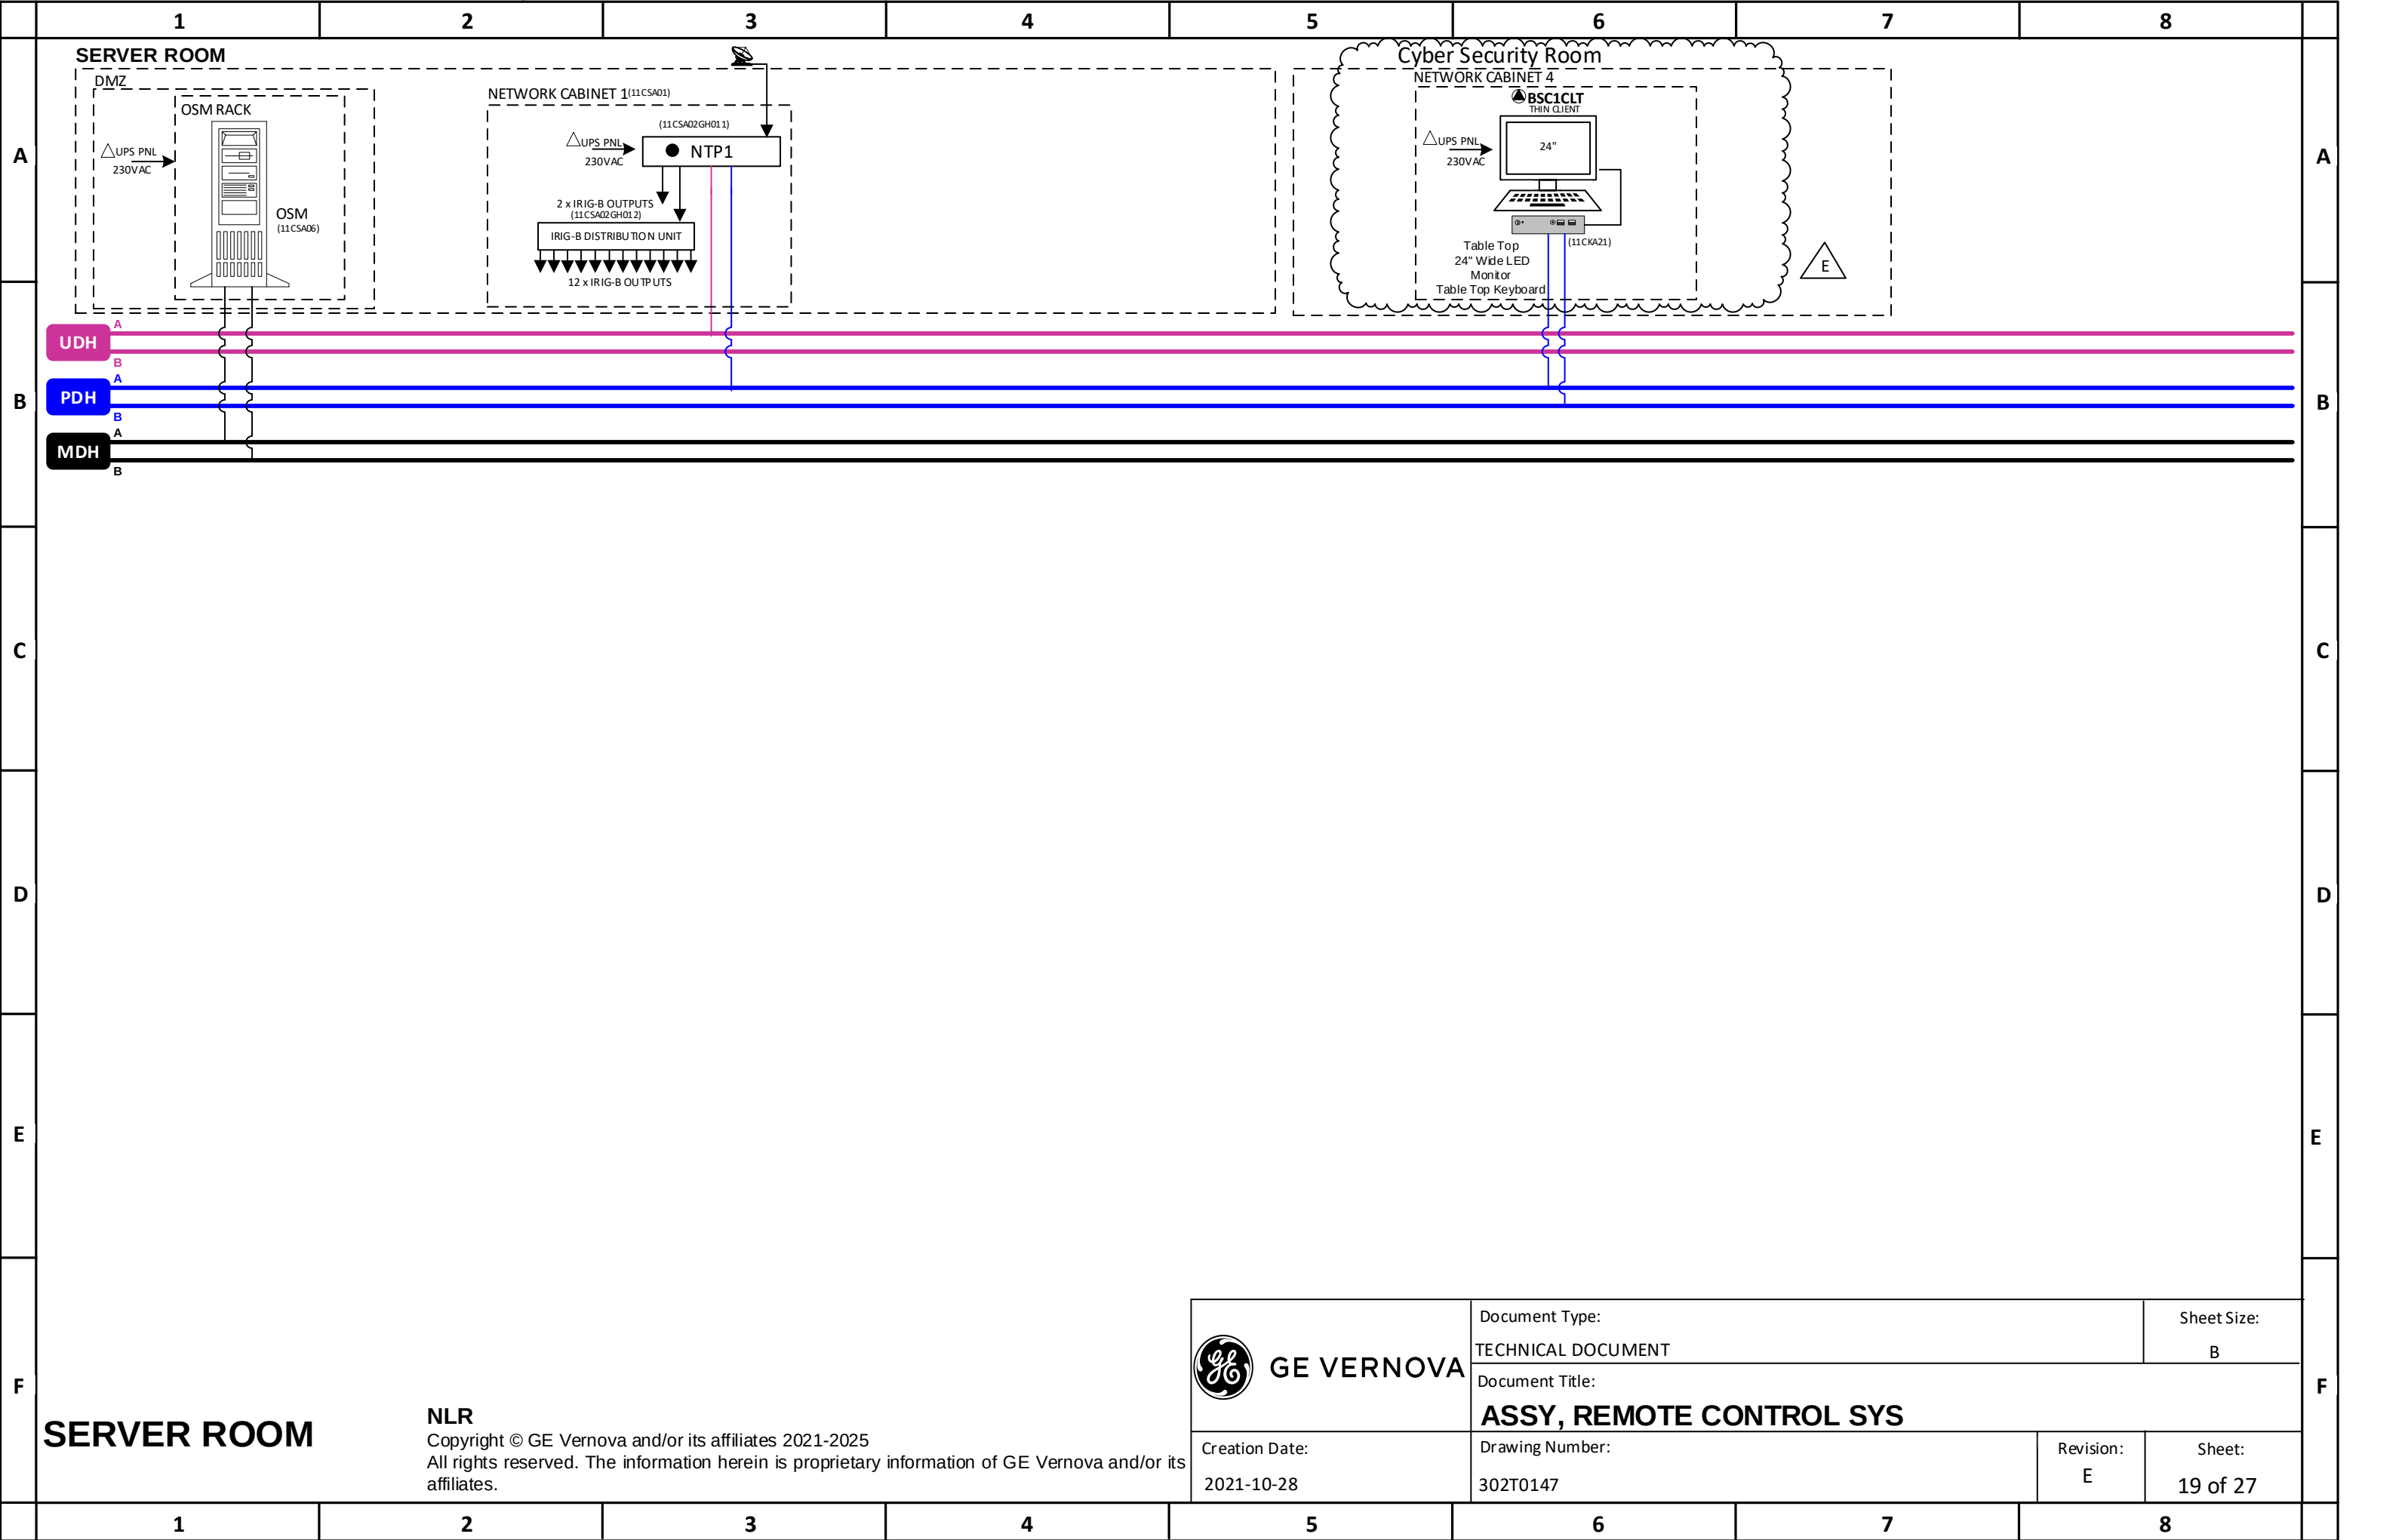

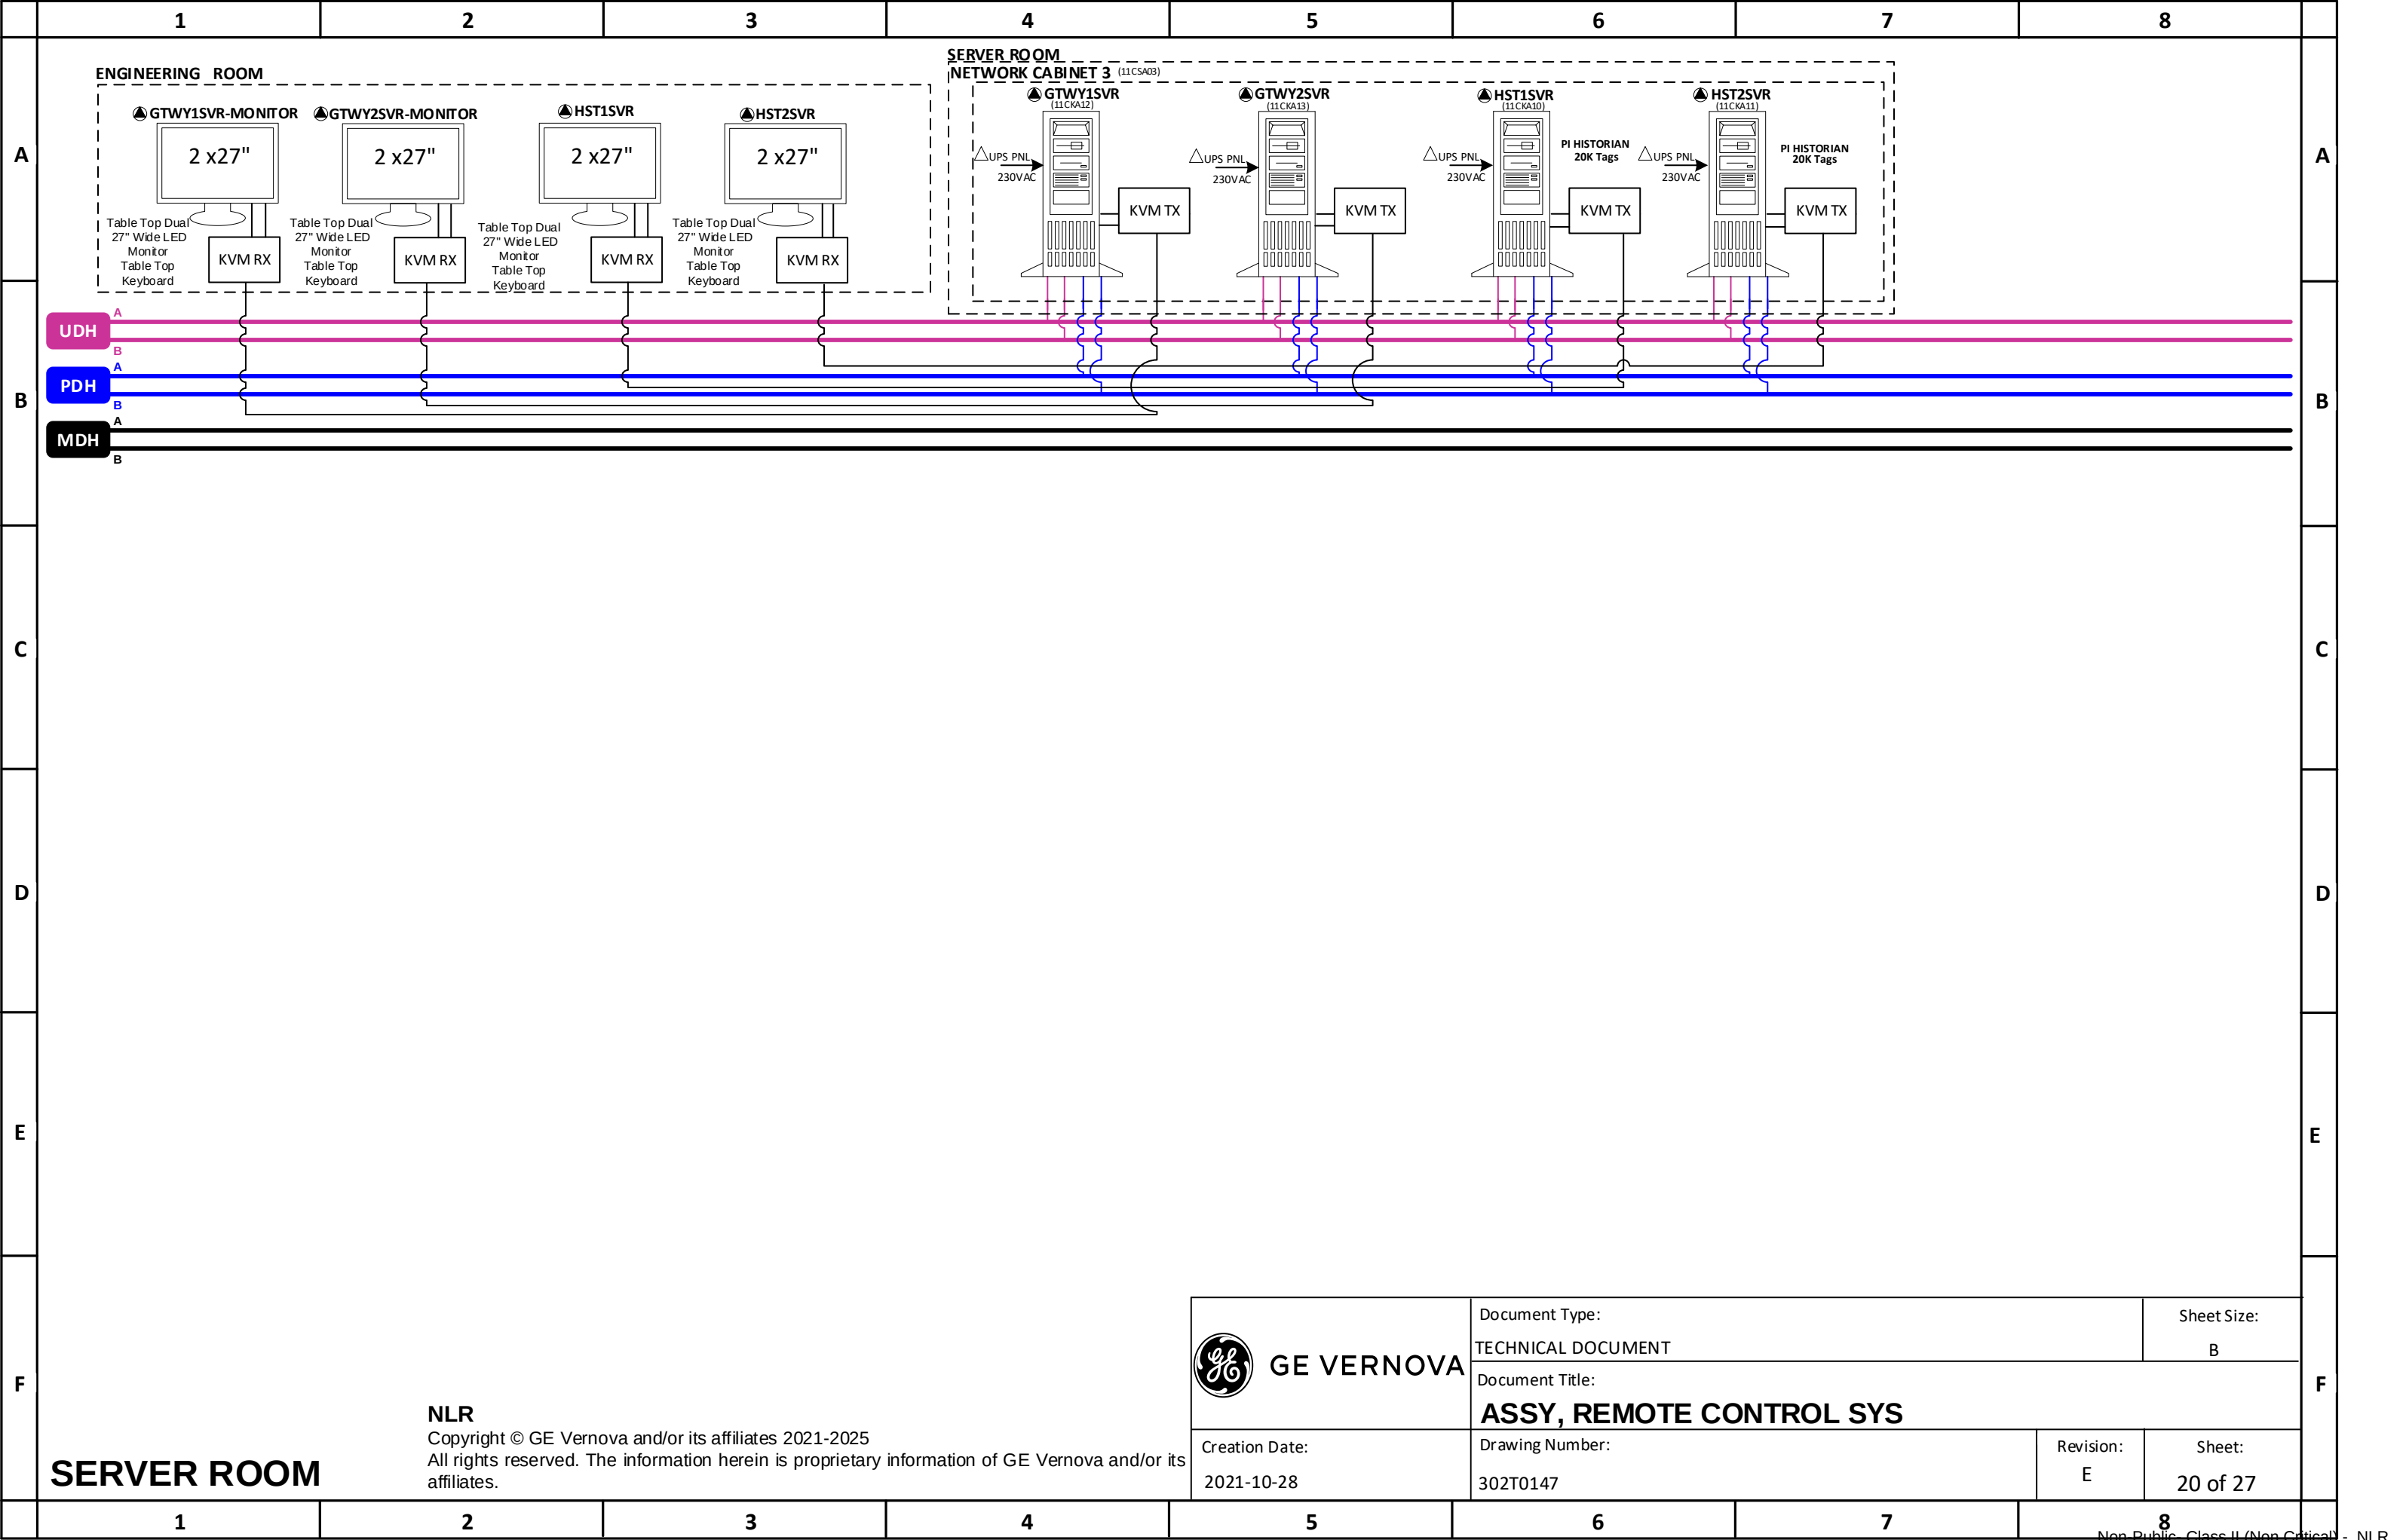

GE VERNOVA

Document Type: TECHNICAL DOCUMENT		Sheet Size: B	
Document Title: ASSY, REMOTE CONTROL SYS			
Drawing Number: 302T0147		Revision: E	Sheet: 20 of 27

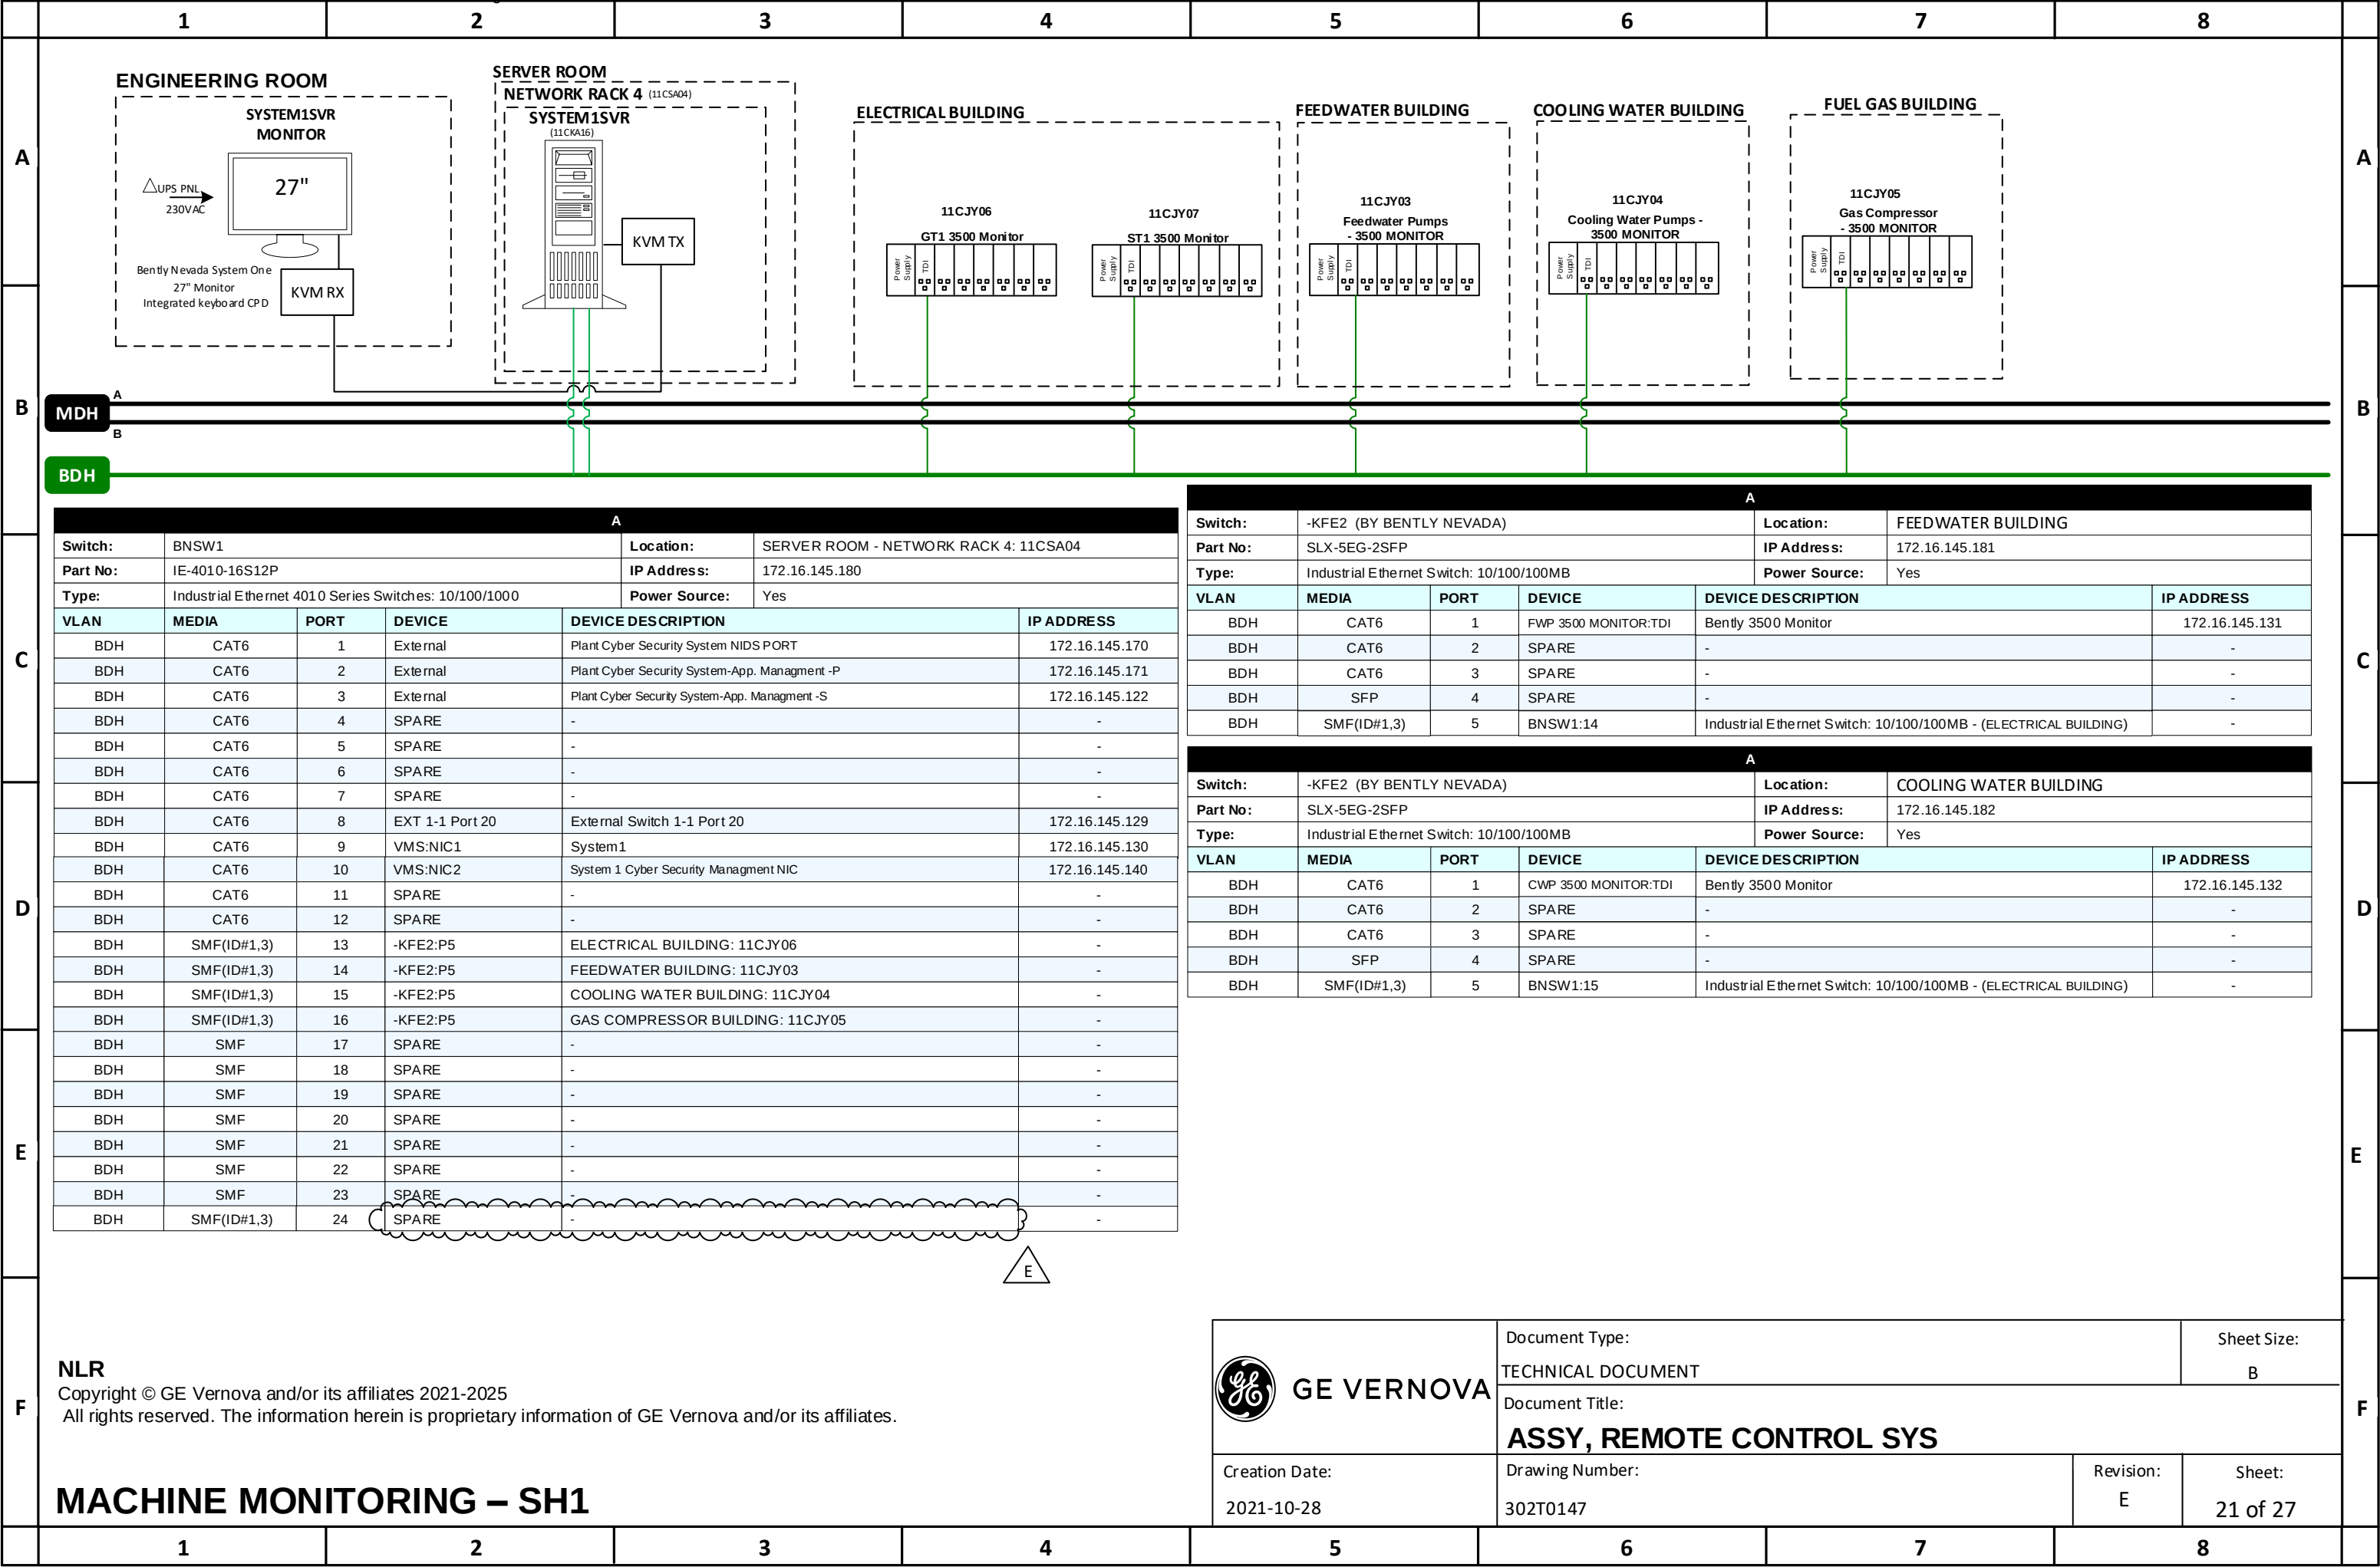

	1	2	3	4	5	6	7	8																																																																																																						
A									A																																																																																																					
B	<table><tr><td colspan="2">Remote IO Connections</td><td></td><td></td><td></td><td></td><td></td><td></td><td></td><td></td><td></td></tr><tr><td>From Location</td><td>System</td><td>Cabinet</td><td>Switch</td><td>Port</td><td>Connector</td><td>To Location</td><td>System</td><td>Cabinet</td><td>Switch</td><td>Port</td></tr><tr><td>UBA (Main Electrical building)</td><td>HRSG1</td><td>LU001</td><td>ESW1R/S</td><td>SFP1</td><td>LC*</td><td>ULA (FW Pump Building)</td><td>HRSG1</td><td>CA003</td><td>ESW1R/S</td><td>SFP1</td></tr><tr><td>UBA (Main Electrical building)</td><td>HRSG1</td><td>LU001</td><td>ESW1R/S</td><td>SFP2</td><td>LC*</td><td>ULA (FW Pump Building)</td><td>HRSG1</td><td>LU002</td><td>ESW1R/S</td><td>SFP1</td></tr><tr><td>UBA (Main Electrical building)</td><td>BOP1</td><td>CA006</td><td>ESW1R/S</td><td>SFP1</td><td>LC*</td><td>UGK (WTP Building)</td><td>BOP1</td><td>LU003</td><td>ESW1R/S</td><td>SFP1</td></tr><tr><td>UBA (Main Electrical building)</td><td>BOP1</td><td>CA006</td><td>ESW1R/S</td><td>SFP2</td><td>LC*</td><td>ULA (FW Pump Building)</td><td>BOP1</td><td>LU004</td><td>ESW1R/S</td><td>SFP1</td></tr><tr><td>UBA (Main Electrical building)</td><td>BOP1</td><td>CA006</td><td>ESW2R/S</td><td>SFP1</td><td>LC*</td><td>ULA (FW Pump Building)</td><td>BOP1</td><td>CA011</td><td>ESW1R/S</td><td>SFP1</td></tr><tr><td>UBA (Main Electrical building)</td><td>BOP2</td><td>LU005</td><td>ESW1R/S</td><td>Port 16</td><td>RJ45</td><td>UBA (Main Electrical building)</td><td>BOP2</td><td>LU006</td><td>ESW1R/S</td><td>Port 16</td></tr><tr><td>UBA (Main Electrical building)</td><td>BOP2</td><td>LU005</td><td>ESW1R/S</td><td>SFP1</td><td>LC*</td><td>UBA15 (Cooling Water Electrical Building)</td><td>BOP2</td><td>LU007</td><td>ESW1R/S</td><td>SFP1</td></tr></table>										Remote IO Connections											From Location	System	Cabinet	Switch	Port	Connector	To Location	System	Cabinet	Switch	Port	UBA (Main Electrical building)	HRSG1	LU001	ESW1R/S	SFP1	LC*	ULA (FW Pump Building)	HRSG1	CA003	ESW1R/S	SFP1	UBA (Main Electrical building)	HRSG1	LU001	ESW1R/S	SFP2	LC*	ULA (FW Pump Building)	HRSG1	LU002	ESW1R/S	SFP1	UBA (Main Electrical building)	BOP1	CA006	ESW1R/S	SFP1	LC*	UGK (WTP Building)	BOP1	LU003	ESW1R/S	SFP1	UBA (Main Electrical building)	BOP1	CA006	ESW1R/S	SFP2	LC*	ULA (FW Pump Building)	BOP1	LU004	ESW1R/S	SFP1	UBA (Main Electrical building)	BOP1	CA006	ESW2R/S	SFP1	LC*	ULA (FW Pump Building)	BOP1	CA011	ESW1R/S	SFP1	UBA (Main Electrical building)	BOP2	LU005	ESW1R/S	Port 16	RJ45	UBA (Main Electrical building)	BOP2	LU006	ESW1R/S	Port 16	UBA (Main Electrical building)	BOP2	LU005	ESW1R/S	SFP1	LC*	UBA15 (Cooling Water Electrical Building)	BOP2	LU007	ESW1R/S	SFP1	B
	Remote IO Connections																																																																																																													
	From Location	System	Cabinet	Switch	Port	Connector	To Location	System	Cabinet	Switch	Port																																																																																																			
	UBA (Main Electrical building)	HRSG1	LU001	ESW1R/S	SFP1	LC*	ULA (FW Pump Building)	HRSG1	CA003	ESW1R/S	SFP1																																																																																																			
	UBA (Main Electrical building)	HRSG1	LU001	ESW1R/S	SFP2	LC*	ULA (FW Pump Building)	HRSG1	LU002	ESW1R/S	SFP1																																																																																																			
	UBA (Main Electrical building)	BOP1	CA006	ESW1R/S	SFP1	LC*	UGK (WTP Building)	BOP1	LU003	ESW1R/S	SFP1																																																																																																			
	UBA (Main Electrical building)	BOP1	CA006	ESW1R/S	SFP2	LC*	ULA (FW Pump Building)	BOP1	LU004	ESW1R/S	SFP1																																																																																																			
	UBA (Main Electrical building)	BOP1	CA006	ESW2R/S	SFP1	LC*	ULA (FW Pump Building)	BOP1	CA011	ESW1R/S	SFP1																																																																																																			
UBA (Main Electrical building)	BOP2	LU005	ESW1R/S	Port 16	RJ45	UBA (Main Electrical building)	BOP2	LU006	ESW1R/S	Port 16																																																																																																				
UBA (Main Electrical building)	BOP2	LU005	ESW1R/S	SFP1	LC*	UBA15 (Cooling Water Electrical Building)	BOP2	LU007	ESW1R/S	SFP1																																																																																																				
C									C																																																																																																					
D									D																																																																																																					
E									E																																																																																																					
F									F																																																																																																					
IO - NET NLR Copyright © GE Vernova and/or its affiliates 2021-2025 All rights reserved. The information herein is proprietary information of GE Vernova and/or its affiliates.  GE VERNOVA Creation Date: 2021-10-28 Document Type: TECHNICAL DOCUMENT Document Title: ASSY, REMOTE CONTROL SYS Sheet Size: B Revision: E Sheet: 24 of 27																																																																																																														
	1	2	3	4	5	6	7	8																																																																																																						

IO - NET

NLR
Copyright © GE Vernova and/or its affiliates 2021-2025
All rights reserved. The information herein is proprietary information of GE Vernova and/or its affiliates.



GE VERNOVA

Document Type:
TECHNICAL DOCUMENT

Document Title:
ASSY, REMOTE CONTROL SYS

Creation Date:
2021-10-28

Drawing Number:
302T0147

Sheet Size:
B

Revision:
E

Sheet:
24 of 27

		1	2	3	4	5	6	7	8							
A	B	C	D	E	F	IP ADDRESS-1					A	B	C	D	E	F
						ADDRESS	VLAN	DEVICE	DESCRIPTION	LOCATION						
						172.16.101.111	UDH	GT1:R	GT1 <R> CONTROLLER	ELECTRICAL BUILDING						
						172.16.101.112	UDH	GT1:S	GT1 <S> CONTROLLER	ELECTRICAL BUILDING						
						172.16.101.135	UDH	GT1S:R	GT1S <R> CONTROLLER	ELECTRICAL BUILDING						
						172.16.101.136	UDH	GT1S:S	GT1S <S> CONTROLLER	ELECTRICAL BUILDING						
						172.16.101.137	UDH	GT1S:T	GT1S <T> CONTROLLER	ELECTRICAL BUILDING						
						172.16.101.116	UDH	E1:M1	E1 - M1 - CONTROLLER	ELECTRICAL BUILDING						
						172.16.101.117	UDH	E1:M2	E1 - M2 - CONTROLLER	ELECTRICAL BUILDING						
						172.16.101.118	UDH	E1:C	E1 - C - CONTROLLER	ELECTRICAL BUILDING						
172.16.101.119	UDH	E1:KEYPAD	E1 - KEYPAD	ELECTRICAL BUILDING												
172.16.101.110	UDH	L1	GT1 STATIC STARTER – LS2100e	ELECTRICAL BUILDING												
172.16.101.211	UDH	ST1:R	ST1 <R> CONTROLLER	ELECTRICAL BUILDING												
172.16.101.212	UDH	ST1:S	ST1 <S> CONTROLLER	ELECTRICAL BUILDING												
172.16.101.222	UDH	ST1S:R	ST1S <R> CONTROLLER	ELECTRICAL BUILDING												
172.16.101.223	UDH	ST1S:S	ST1S <S> CONTROLLER	ELECTRICAL BUILDING												
172.16.101.224	UDH	ST1S:T	ST1S <T> CONTROLLER	ELECTRICAL BUILDING												
172.16.101.40	UDH	BOP1:R	BOP1 <R> CONTROLLER	ELECTRICAL BUILDING												
172.16.101.41	UDH	BOP1:S	BOP1 <S> CONTROLLER	ELECTRICAL BUILDING												
172.16.101.73	UDH	BOP2:R	BOP2 <R> CONTROLLER	ELECTRICAL BUILDING												
172.16.101.74	UDH	BOP2:S	BOP2 <S> CONTROLLER	ELECTRICAL BUILDING												
172.16.101.30	UDH	HRS G1:R	HRS G1 <R> CONTROLLER	ELECTRICAL BUILDING												
172.16.101.31	UDH	HRS G1:S	HRS G1 <S> CONTROLLER	ELECTRICAL BUILDING												
172.16.101.138	UDH	HRS G1S:R	HRS G1S <R> CONTROLLER	FEED WATER BUILDING												
172.16.101.139	UDH	HRS G1S:S	HRS G1S <S> CONTROLLER	FEED WATER BUILDING												
172.16.101.140	UDH	HRS G1S:T	HRS G1S <T> CONTROLLER	FED WATER BUILDING												
172.16.205.40	PDH	PRN1	A4 COLOR LASER PRINTER	ELECTRICAL BUILDING												
172.16.205.41	PDH	PRN2	A3 COLOR LASER PRINTER	CENTRAL CONTROL ROOM												
172.16.205.42	PDH	PRN3	A3 COLOR LASER PRINTER	CENTRAL CONTROL ROOM												
172.16.205.43	PDH	PRN4	A3 COLOR LASER PRINTER	ENGINEERING ROOM												
172.16.205.44	PDH	PRN5	A3 COLOR LASER PRINTER	ENGINEERING ROOM												
172.16.205.45	PDH	PRN6	A3 COLOR LASER PRINTER	ENGINEERING ROOM												
172.16.205.46	PDH	PRN7	A3 COLOR LASER PRINTER	ENGINEERING ROOM												
172.16.205.38	PDH	HST1SVR	HISTORIAN	SERVER ROOM												
172.16.101.20	UDH	uHST1SVR	HISTORIAN	SERVER ROOM												
172.16.205.39	PDH	HST2SVR	HISTORIAN	SERVER ROOM												
172.16.101.21	UDH	uHST2SVR	HISTORIAN	SERVER ROOM												
172.16.101.250	UDH	NTP	NTP TIME SYNCH1	SERVER ROOM												
172.16.205.250	PDH	uNTP	NTP TIME SYNCH1	SERVER ROOM												
172.16.16.71	MDH	SYSTEM1	BENTLY SYSTEM ONE	ENGINEERING ROOM												
172.16.200.1	PDH	GT1CLT	THIN CLIENT	ELECTRICAL BUILDING												
172.16.200.3	PDH	EWS1CLT	THIN CLIENT	ENGINEERING ROOM												
172.16.200.4	PDH	EWS2CLT	THIN CLIENT	ENGINEERING ROOM												
172.16.200.5	PDH	OWS1CLT	THIN CLIENT	CENTRAL CONTROL ROOM												
172.16.200.6	PDH	OWS2CLT	THIN CLIENT	CENTRAL CONTROL ROOM												
172.16.200.7	PDH	OWS3CLT	THIN CLIENT	CENTRAL CONTROL ROOM												
172.16.200.8	PDH	OWS4CLT	THIN CLIENT	CENTRAL CONTROL ROOM												
172.16.200.9	PDH	OWS5CLT	THIN CLIENT	SHIFT SUPERVISORS OFFICE												
172.16.200.10	PDH	STOWCLT	THIN CLIENT	ENGINEERING ROOM												
NLR					Copyright © GE Vernova and/or its affiliates 2021-2025											
All rights reserved. The information herein is proprietary information of GE Vernova and/or its affiliates.																
IP ADDRESS-1																
		1	2	3	4	5	6	7	8							
		1	2	3	4	5	6	7	8							
		1	2	3	4	5	6									

1		2		3		4		5		6		7		8																																																				
A	<table><thead><tr><th>ADDRESS</th><th>VLAN</th><th>DEVICE</th><th>DESCRIPTION</th><th>LOCATION</th></tr></thead><tbody><tr><td>172.16.205.150</td><td>PDH</td><td>EDGE1SVR</td><td>VIRTUAL FIELD AGENT</td><td>SERVER ROOM</td></tr><tr><td>172.16.101.150</td><td>UDH</td><td>uEDGE1SVR</td><td>VIRTUAL FIELD AGENT</td><td>SERVER ROOM</td></tr><tr><td>172.16.198.8</td><td>PDH</td><td>HS3</td><td>VIRTUAL HOST SERVER 3</td><td>SERVER ROOM</td></tr><tr><td>172.16.198.9</td><td>PDH</td><td>HS4</td><td>VIRTUAL HOST SERVER 4</td><td>SERVER ROOM</td></tr><tr><td>172.16.198.10</td><td>PDH</td><td>HW2</td><td>WITNESS/ ADMINISTRATIVE CONSOLE</td><td>SERVER ROOM</td></tr><tr><td>172.16.198.16</td><td>PDH</td><td>ACRONIS-VA-HS1</td><td>ACRONIS VIRTUAL APPLIANCE HS1</td><td>SERVER ROOM</td></tr><tr><td>172.16.198.17</td><td>PDH</td><td>ACRONIS-VA-HS2</td><td>ACRONIS VIRTUAL APPLIANCE HS2</td><td>SERVER ROOM</td></tr><tr><td>172.16.198.18</td><td>PDH</td><td>ACRONIS-VA-HS3</td><td>ACRONIS VIRTUAL APPLIANCE HS3</td><td>SERVER ROOM</td></tr><tr><td>172.16.198.19</td><td>PDH</td><td>ACRONIS-VA-HS4</td><td>ACRONIS VIRTUAL APPLIANCE HS4</td><td>SERVER ROOM</td></tr></tbody></table>															ADDRESS	VLAN	DEVICE	DESCRIPTION	LOCATION	172.16.205.150	PDH	EDGE1SVR	VIRTUAL FIELD AGENT	SERVER ROOM	172.16.101.150	UDH	uEDGE1SVR	VIRTUAL FIELD AGENT	SERVER ROOM	172.16.198.8	PDH	HS3	VIRTUAL HOST SERVER 3	SERVER ROOM	172.16.198.9	PDH	HS4	VIRTUAL HOST SERVER 4	SERVER ROOM	172.16.198.10	PDH	HW2	WITNESS/ ADMINISTRATIVE CONSOLE	SERVER ROOM	172.16.198.16	PDH	ACRONIS-VA-HS1	ACRONIS VIRTUAL APPLIANCE HS1	SERVER ROOM	172.16.198.17	PDH	ACRONIS-VA-HS2	ACRONIS VIRTUAL APPLIANCE HS2	SERVER ROOM	172.16.198.18	PDH	ACRONIS-VA-HS3	ACRONIS VIRTUAL APPLIANCE HS3	SERVER ROOM	172.16.198.19	PDH	ACRONIS-VA-HS4	ACRONIS VIRTUAL APPLIANCE HS4	SERVER ROOM	A
	ADDRESS	VLAN	DEVICE	DESCRIPTION	LOCATION																																																													
	172.16.205.150	PDH	EDGE1SVR	VIRTUAL FIELD AGENT	SERVER ROOM																																																													
	172.16.101.150	UDH	uEDGE1SVR	VIRTUAL FIELD AGENT	SERVER ROOM																																																													
	172.16.198.8	PDH	HS3	VIRTUAL HOST SERVER 3	SERVER ROOM																																																													
	172.16.198.9	PDH	HS4	VIRTUAL HOST SERVER 4	SERVER ROOM																																																													
	172.16.198.10	PDH	HW2	WITNESS/ ADMINISTRATIVE CONSOLE	SERVER ROOM																																																													
	172.16.198.16	PDH	ACRONIS-VA-HS1	ACRONIS VIRTUAL APPLIANCE HS1	SERVER ROOM																																																													
	172.16.198.17	PDH	ACRONIS-VA-HS2	ACRONIS VIRTUAL APPLIANCE HS2	SERVER ROOM																																																													
	172.16.198.18	PDH	ACRONIS-VA-HS3	ACRONIS VIRTUAL APPLIANCE HS3	SERVER ROOM																																																													
172.16.198.19	PDH	ACRONIS-VA-HS4	ACRONIS VIRTUAL APPLIANCE HS4	SERVER ROOM																																																														
B	<table><tbody><tr><td>172.16.198.15</td><td>PDH</td><td>ACRONIS-VA-MC2</td><td>ACRONIS VIRTUAL APPLIANCE MC2</td><td>SERVER ROOM</td></tr><tr><td>172.16.198.20</td><td>PDH</td><td>ACRONIS-VA-MC4</td><td>ACRONIS VIRTUAL APPLIANCE MC4</td><td>SERVER ROOM</td></tr><tr><td>172.16.199.14</td><td>PDH</td><td>MC4</td><td>WITNESS HOST SERVER</td><td>SERVER ROOM</td></tr><tr><td>172.16.205.109</td><td>PDH</td><td>WIN1SVR</td><td>WINDOWS SERVER VM</td><td>SERVER ROOM</td></tr><tr><td>172.16.205.110</td><td>PDH</td><td>ENMELM</td><td>BSC LOGGING & SIEM APPLIANCE</td><td>SERVER ROOM</td></tr><tr><td>172.16.200.11</td><td>PDH</td><td>BSC1CLT</td><td>HYPER VISOR SERVER</td><td>CYBER SECURITY ROOM</td></tr><tr><td>172.16.198.7</td><td>PDH</td><td>HC2</td><td>VCENTER SERVER</td><td>SERVER ROOM</td></tr><tr><td>172.16.101.105</td><td>UDH</td><td>uCA1</td><td>CERTIFICATE AUTHORITY SERVER</td><td>SERVER ROOM</td></tr><tr><td>172.16.199.220</td><td>PDH</td><td>NAS</td><td>NAS SERVER</td><td>SERVER ROOM</td></tr><tr><td>172.16.202.1</td><td>PDH</td><td>SW1-1</td><td>EDGE SWITCH</td><td>ELECTRICAL BUILDING</td></tr></tbody></table>															172.16.198.15	PDH	ACRONIS-VA-MC2	ACRONIS VIRTUAL APPLIANCE MC2	SERVER ROOM	172.16.198.20	PDH	ACRONIS-VA-MC4	ACRONIS VIRTUAL APPLIANCE MC4	SERVER ROOM	172.16.199.14	PDH	MC4	WITNESS HOST SERVER	SERVER ROOM	172.16.205.109	PDH	WIN1SVR	WINDOWS SERVER VM	SERVER ROOM	172.16.205.110	PDH	ENMELM	BSC LOGGING & SIEM APPLIANCE	SERVER ROOM	172.16.200.11	PDH	BSC1CLT	HYPER VISOR SERVER	CYBER SECURITY ROOM	172.16.198.7	PDH	HC2	VCENTER SERVER	SERVER ROOM	172.16.101.105	UDH	uCA1	CERTIFICATE AUTHORITY SERVER	SERVER ROOM	172.16.199.220	PDH	NAS	NAS SERVER	SERVER ROOM	172.16.202.1	PDH	SW1-1	EDGE SWITCH	ELECTRICAL BUILDING	B
	172.16.198.15	PDH	ACRONIS-VA-MC2	ACRONIS VIRTUAL APPLIANCE MC2	SERVER ROOM																																																													
	172.16.198.20	PDH	ACRONIS-VA-MC4	ACRONIS VIRTUAL APPLIANCE MC4	SERVER ROOM																																																													
	172.16.199.14	PDH	MC4	WITNESS HOST SERVER	SERVER ROOM																																																													
	172.16.205.109	PDH	WIN1SVR	WINDOWS SERVER VM	SERVER ROOM																																																													
	172.16.205.110	PDH	ENMELM	BSC LOGGING & SIEM APPLIANCE	SERVER ROOM																																																													
	172.16.200.11	PDH	BSC1CLT	HYPER VISOR SERVER	CYBER SECURITY ROOM																																																													
	172.16.198.7	PDH	HC2	VCENTER SERVER	SERVER ROOM																																																													
	172.16.101.105	UDH	uCA1	CERTIFICATE AUTHORITY SERVER	SERVER ROOM																																																													
	172.16.199.220	PDH	NAS	NAS SERVER	SERVER ROOM																																																													
172.16.202.1	PDH	SW1-1	EDGE SWITCH	ELECTRICAL BUILDING																																																														
C	<table><tbody><tr><td>172.16.202.1</td><td>PDH</td><td>SW1-2</td><td>EDGE SWITCH</td><td>ELECTRICAL BUILDING</td></tr><tr><td>172.16.202.2</td><td>PDH</td><td>SW2-1</td><td>EDGE SWITCH</td><td>SERVER ROOM</td></tr><tr><td>172.16.202.2</td><td>PDH</td><td>SW2-2</td><td>EDGE SWITCH</td><td>SERVER ROOM</td></tr><tr><td>172.16.202.3</td><td>PDH</td><td>SW3-1</td><td>EDGE SWITCH</td><td>SERVER ROOM</td></tr><tr><td>172.16.202.3</td><td>PDH</td><td>SW3-2</td><td>EDGE SWITCH</td><td>SERVER ROOM</td></tr><tr><td>172.16.202.4</td><td>PDH</td><td>SW4-1</td><td>EDGE SWITCH</td><td>SERVER ROOM</td></tr><tr><td>172.16.202.4</td><td>PDH</td><td>SW4-2</td><td>EDGE SWITCH</td><td>SERVER ROOM</td></tr><tr><td>172.16.202.5</td><td>PDH</td><td>SW5-1</td><td>EDGE SWITCH</td><td>SERVER ROOM</td></tr><tr><td>172.16.202.5</td><td>PDH</td><td>SW5-2</td><td>EDGE SWITCH</td><td>SERVER ROOM</td></tr><tr><td>172.16.202.6</td><td>PDH</td><td>SW6-1</td><td>EDGE SWITCH</td><td>ELECTRICAL BUILDING</td></tr></tbody></table>															172.16.202.1	PDH	SW1-2	EDGE SWITCH	ELECTRICAL BUILDING	172.16.202.2	PDH	SW2-1	EDGE SWITCH	SERVER ROOM	172.16.202.2	PDH	SW2-2	EDGE SWITCH	SERVER ROOM	172.16.202.3	PDH	SW3-1	EDGE SWITCH	SERVER ROOM	172.16.202.3	PDH	SW3-2	EDGE SWITCH	SERVER ROOM	172.16.202.4	PDH	SW4-1	EDGE SWITCH	SERVER ROOM	172.16.202.4	PDH	SW4-2	EDGE SWITCH	SERVER ROOM	172.16.202.5	PDH	SW5-1	EDGE SWITCH	SERVER ROOM	172.16.202.5	PDH	SW5-2	EDGE SWITCH	SERVER ROOM	172.16.202.6	PDH	SW6-1	EDGE SWITCH	ELECTRICAL BUILDING	C
	172.16.202.1	PDH	SW1-2	EDGE SWITCH	ELECTRICAL BUILDING																																																													
	172.16.202.2	PDH	SW2-1	EDGE SWITCH	SERVER ROOM																																																													
	172.16.202.2	PDH	SW2-2	EDGE SWITCH	SERVER ROOM																																																													
	172.16.202.3	PDH	SW3-1	EDGE SWITCH	SERVER ROOM																																																													
	172.16.202.3	PDH	SW3-2	EDGE SWITCH	SERVER ROOM																																																													
	172.16.202.4	PDH	SW4-1	EDGE SWITCH	SERVER ROOM																																																													
	172.16.202.4	PDH	SW4-2	EDGE SWITCH	SERVER ROOM																																																													
	172.16.202.5	PDH	SW5-1	EDGE SWITCH	SERVER ROOM																																																													
	172.16.202.5	PDH	SW5-2	EDGE SWITCH	SERVER ROOM																																																													
172.16.202.6	PDH	SW6-1	EDGE SWITCH	ELECTRICAL BUILDING																																																														
D	<table><tbody><tr><td>172.16.202.6</td><td>PDH</td><td>SW6-2</td><td>EDGE SWITCH</td><td>ELECTRICAL BUILDING</td></tr><tr><td>172.16.202.7</td><td>PDH</td><td>SW7-1</td><td>EDGE SWITCH</td><td>LEC BUILDING</td></tr><tr><td>172.16.202.7</td><td>PDH</td><td>SW7-2</td><td>EDGE SWITCH</td><td>LEC BUILDING</td></tr><tr><td>172.16.205.247</td><td>PDH</td><td>RB1-1</td><td>ROOT BRIDGE SWITCH</td><td>SERVER ROOM</td></tr><tr><td>172.16.205.247</td><td>PDH</td><td>RB1-2</td><td>ROOT BRIDGE SWITCH</td><td>SERVER ROOM</td></tr><tr><td>172.16.203.1</td><td>PDH</td><td>SWP1</td><td>IE2K SWITCH</td><td>FEED WATER BUILDING</td></tr><tr><td>172.16.203.2</td><td>PDH</td><td>SWP2</td><td>IE2K SWITCH</td><td>FEED WATER BUILDING</td></tr><tr><td>172.16.205.151</td><td>PDH</td><td>EDGE2SVR</td><td>VIRTUAL FIELD AGENT</td><td>SERVER ROOM</td></tr><tr><td>172.16.101.151</td><td>UDH</td><td>uEDGE2SVR</td><td>VIRTUAL FIELD AGENT</td><td>SERVER ROOM</td></tr></tbody></table>															172.16.202.6	PDH	SW6-2	EDGE SWITCH	ELECTRICAL BUILDING	172.16.202.7	PDH	SW7-1	EDGE SWITCH	LEC BUILDING	172.16.202.7	PDH	SW7-2	EDGE SWITCH	LEC BUILDING	172.16.205.247	PDH	RB1-1	ROOT BRIDGE SWITCH	SERVER ROOM	172.16.205.247	PDH	RB1-2	ROOT BRIDGE SWITCH	SERVER ROOM	172.16.203.1	PDH	SWP1	IE2K SWITCH	FEED WATER BUILDING	172.16.203.2	PDH	SWP2	IE2K SWITCH	FEED WATER BUILDING	172.16.205.151	PDH	EDGE2SVR	VIRTUAL FIELD AGENT	SERVER ROOM	172.16.101.151	UDH	uEDGE2SVR	VIRTUAL FIELD AGENT	SERVER ROOM	D					
	172.16.202.6	PDH	SW6-2	EDGE SWITCH	ELECTRICAL BUILDING																																																													
	172.16.202.7	PDH	SW7-1	EDGE SWITCH	LEC BUILDING																																																													
	172.16.202.7	PDH	SW7-2	EDGE SWITCH	LEC BUILDING																																																													
	172.16.205.247	PDH	RB1-1	ROOT BRIDGE SWITCH	SERVER ROOM																																																													
	172.16.205.247	PDH	RB1-2	ROOT BRIDGE SWITCH	SERVER ROOM																																																													
	172.16.203.1	PDH	SWP1	IE2K SWITCH	FEED WATER BUILDING																																																													
	172.16.203.2	PDH	SWP2	IE2K SWITCH	FEED WATER BUILDING																																																													
	172.16.205.151	PDH	EDGE2SVR	VIRTUAL FIELD AGENT	SERVER ROOM																																																													
	172.16.101.151	UDH	uEDGE2SVR	VIRTUAL FIELD AGENT	SERVER ROOM																																																													
E																E																																																		
	F																F																																																	
		IP ADDRESS-2																																																																
		NLR																																																																
		Copyright © GE Vernova and/or its affiliates 2021-2025																																																																
		All rights reserved. The information herein is proprietary information of GE Vernova and/or its affiliates.																																																																



	1	2	3	4	5	6	7	8	
A	TERM	DESCRIPTION	TERM	DESCRIPTION	TERM	DESCRIPTION	TERM	DESCRIPTION	A
B	TERM	DESCRIPTION	TERM	DESCRIPTION	TERM	DESCRIPTION	TERM	DESCRIPTION	B
C	TERM	DESCRIPTION	TERM	DESCRIPTION	TERM	DESCRIPTION	TERM	DESCRIPTION	C
D	TERM	DESCRIPTION	TERM	DESCRIPTION	TERM	DESCRIPTION	TERM	DESCRIPTION	D
E	TERM	DESCRIPTION	TERM	DESCRIPTION	TERM	DESCRIPTION	TERM	DESCRIPTION	E
F	TERM	DESCRIPTION	TERM	DESCRIPTION	TERM	DESCRIPTION	TERM	DESCRIPTION	F
	1	2	3	4	5	6	7	8	

Acronyms

NLR

Copyright © GE Vernova and/or its affiliates 2021-2025
All rights reserved. The information herein is proprietary information of GE Vernova and/or its affiliates.



GE VERNOVA

Document Type:
TECHNICAL DOCUMENT

Sheet Size:
B

Document Title:
ASSY, REMOTE CONTROL SYS

Creation Date:
2021-10-28

Drawing Number:
302T0147

Revision:
E

Sheet:
27 of 27